

CARD MUST BE TYPED

State of Kansas
NOTICE OF INTENTION TO DRILL
(see rules on reverse side)

CARD MUST BE SIGNED

Starting Date: 7/11/85
month day year 11:50

API Number 15- 195-21,748-00-00

OPERATOR: License # 4472
Name N.F. Producers, Inc.
Address 5151 W. 1st Ave.
City/State/Zip Denver, CO 80214
Contact Person Tom Skinner
Phone 303-934-2464

SE .SE. SE. ... Sec 34. Twp 11. S, Rge 21. East
(location) West

440
330
Ft North from Southeast Corner of Section
Ft West from Southeast Corner of Section
(Note: Locate well on Section Plat on reverse side)

CONTRACTOR: License # 6033
Name Murfin Drilling
City/State 250 N. Water, Wichita, KS 67202

Nearest lease or unit boundary line 330 feet.
County Trego
Lease Name Ambruster "A" Well# 1
Domestic well within 330 feet: yes no
Municipal well within one mile: yes no

Well Drilled For: Well Class: Type Equipment:
 Oil Swd Infield Mud Rotary
 Gas Inj Pool Ext. Air Rotary
 OWWO Expl Wildcat Cable

Depth to Bottom of fresh water 90 feet
Lowest usable water formation Dakota
Depth to Bottom of usable water ~~330~~ 1000 feet
Surface pipe by Alternate: 1 2
Surface pipe to be set 250 feet
Conductor pipe if any required feet
Ground surface elevation 2300 feet MSL
This Authorization Expires 7-11-86
Approved By 7-11-85 [Signature]

If OWWO: old well info as follows:

Operator
Well Name
Comp Date Old Total Depth
Projected Total Depth 4100 feet
Projected Formation at TD Arbuckle
Expected Producing Formations

I certify that we will comply with K.S.A. 55-101, et seq., plus eventually plugging hole to K.C.C. specifications.

Production will be cemented immediately AS Agent

Date 7/11/85 Signature of Operator or Agent [Signature] Title

RCH FORKONE

Must be filed with the K.C.C. five (5) days prior to commencing well
This card void if drilling not started within six (6) months of date received by K.C.C.

RECEIVED
STATE CORPORATION COMMISSION


7-11-1985
JUL 11 1985

Important procedures to follow:

A Regular Section of Land
1 Mile = 5,280 Ft.

CONSERVATION DIVISION
Wichita, Kansas

1. Notify District office before setting surface casing.
2. Set surface casing by circulating cement to the top.
3. File completion forms ACO-1 with K.C.C. within 90 days of well completion, following instructions on ACO-1, side 1, and including copies of wireline logs.
4. Notify District office 48 hours prior to old well workover or re-entry.
5. Prior to plugging, prepare a plugging plan, then obtain agreement from the appropriate district office for an approved plugging plan.
6. Submit plugging report (CP-4) to K.C.C. after plugging is completed.
7. Obtain an approved injection docket number before disposing of salt water.
8. Notify K.C.C. within 10 days when injection commences or terminates.
9. If an alternate 2 completion, cement in the production pipe from below any usable water to surface within 120 days of spud date.

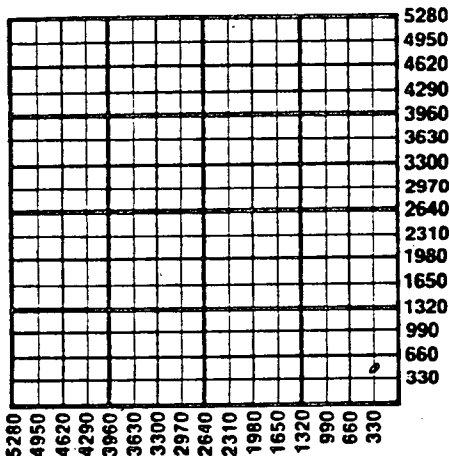

State Corporation Commission of Kansas
Conservation Division
200 Colorado Derby Building
Wichita, Kansas 67202
(316) 263-3238