

CARD MUST BE TYPED

State of Kansas
NOTICE OF INTENTION TO DRILL
(see rules on reverse side)

CARD MUST BE SIGNED

Starting Date: April 7, 1985
month day year

API Number 15- 195-21,706-00-00

OPERATOR: License # 8728

E/2 W/2 NW Sec. 2 Twp 11 S, Rge 22
(location) East West

Name Rockhound Resources, Inc.

Address P.O. Box 1010

City/State/Zip Great Bend, KS 67530

Contact Person Rod Tremblay/James Musgrove

Phone (316)-792-8251

3960' Ft North from Southeast Corner of Section
4290' Ft West from Southeast Corner of Section
(Note: Locate well on Section Plat on reverse side)

CONTRACTOR: License # 4087

Name Williamson Drilling Co.

City/State Great Bend, KS 67530

Nearest lease or unit boundary line 990 feet.

County Trego

Lease Name Hilgers "A" Well# 1

Well Drilled For: Well Class: Type Equipment:

- Oil Swd Infield Mud Rotary
- Gas Inj Pool Ext. Air Rotary
- OWWO Expl Wildcat Cable

Domestic well within 330 feet: yes no

Municipal well within one mile: yes no

If OWWO: old well info as follows:

Depth to Bottom of fresh water feet

Lowest usable water formation Dakota

Depth to Bottom of usable water 900 feet

Surface pipe by Alternate: 1 2

Surface pipe to be set 275 feet

Conductor pipe if any required No feet

Ground surface elevation N/A feet MSL

This Authorization Expires 10-2-85

Approved By 4-2-85 [Signature]

Operator

Well Name

Comp Date Old Total Depth

Projected Total Depth 3850 feet

Projected Formation at TD Arbuckle

Expected Producing Formations Lansing/Marmaton

I certify that we will comply with K.S.A. 55-101, et seq., plus eventually plugging hole to K.C.C. specifications.

Date APRIL 1, 1985 Signature of Operator or Agent [Signature]


Title Sec.-Treas.

MHC/UDHE 4-2-85

Must be filed with the K.C.C. five (5) days prior to commencing well
This card void if drilling not started within six (6) months of date received by K.C.C.

Important procedures to follow :

**A Regular Section of Land
1 Mile = 5,280 Ft.**

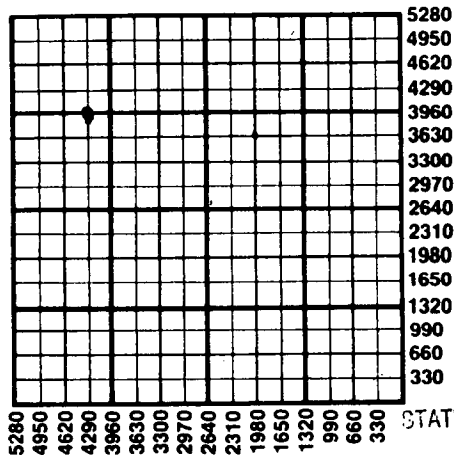

1. Notify District office before setting surface casing.
2. Set surface casing by circulating cement to the top.
3. File completion forms ACO-1 with K.C.C. within 90 days of well completion, following instructions on ACO-1, side 1, and including copies of wireline logs.
4. Notify District office 48 hours prior to old well workover or re-entry.
5. Prior to plugging, prepare a plugging plan, then obtain agreement from the appropriate district office for an approved plugging plan.
6. Submit plugging report (CP-4) to K.C.C. after plugging is completed.
7. Obtain an approved injection docket number before disposing of salt water.
8. Notify K.C.C. within 10 days when injection commences or terminates.
9. If an alternate 2 completion, cement in the production pipe from below any usable water to surface within 120 days of spud date.

RECEIVED
STATE CORPORATION COMMISSION

APR 02 1985
4-2-1985
CONSERVATION DIVISION
Wichita, Kansas

State Corporation Commission of Kansas
Conservation Division
200 Colorado Derby Building
Wichita, Kansas 67202
(316) 263-3238