

CARD MUST BE TYPED

State of Kansas

CARD MUST BE SIGNED

# NOTICE OF INTENTION TO DRILL

(see rules on reverse side)

Starting Date November 17, 1986  
month day year

API Number 15— 195-21,883-00-00

OPERATOR: License # 7875  
Name Strata Energy Resources Corporation  
Address 4101 Birch, Ste. 130  
City/State/Zip Newport Beach, California 92629  
Contact Person Raymond A. Diaz  
Phone 714/261-8181

NW SE SE 22 11 S, Rg. 22 ~~Dist~~ XX West  
990  
990  
Ft. from South Line of Section  
Ft. from East Line of Section

(Note: Locate well on Section Plat on reverse side)

CONTRACTOR: License # 567  
Name contractor not selected  
City/State Russell, KS

Nearest lease or unit boundary line 990 feet  
County Irego  
Lease Name Shubert Well # T

Well Drilled For: Well Class: Type Equipment:  
XX Oil — SWD — Infield X Mud Rotary  
— Gas — Inj XX Pool Ext. — Air Rotary  
— OWWO — Expl — Wildcat — Cable

Ground surface elevation 2267 feet MSL  
Domestic well within 330 feet: —yes XX no  
Municipal well within one mile: —yes XX no

If OWWO: old well info as follows:  
Operator  
Well Name  
Comp Date Old Total Depth

Depth to bottom of fresh water 95  
Depth to bottom of usable water ~~1100~~ 950  
Surface pipe by Alternate: 1 2 XX

I certify that well will comply with K.S.A. 55-101, et seq., plus eventually plugging hole to KCC specifications.  
Date 11/3/86 Signature of Operator or Agent [Signature] Title President


For KCC Use:  
Conductor Pipe Required \_\_\_\_\_ feet; Minimum Surface Pipe Required 200 feet per Alt. 2  
This Authorization Expires 5-5-87 Approved By 11-5-86

Must be filed with the K.C.C. five (5) days prior to commencing well  
This card void if drilling not started within six (6) months of date received by K.C.C.

### Important procedures to follow:

1. Notify District office before setting surface casing.
2. Set surface casing by circulating cement to the top.
3. File completion forms ACO-1 with K.C.C. within 90 days of well completion, following instructions on ACO-1, side 1, and including copies of wireline logs.
4. Notify District office 48 hours prior to old well workover or re-entry.
5. Prior to filing Intent, prepare a proposed plugging plan in case well is D & A, then obtain approval of plan when calling district office prior to setting surface pipe.
6. Submit plugging report (CP-4) to K.C.C. after plugging is completed.
7. Obtain an approved injection docket number before disposing of salt water.
8. Notify K.C.C. within 10 days when injection commences or terminates.
9. If an alternate 2 completion, cement in the production pipe from below any usable water to surface within 120 days of spud date.

### A Regular Section of Land 1 Mile = 5,280 Ft.

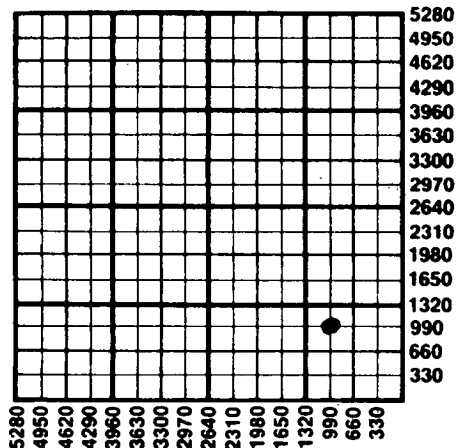

11-5-1986  
NOV 5 1986

State Corporation Commission of Kansas  
Conservation Division  
200 Colorado Derby Building  
Wichita, Kansas 67202  
(316) 263-3238