

CARD MUST BE TYPED

State of Kansas

CARD MUST BE SIGNED

NOTICE OF INTENTION TO DRILL SPOT LOCATION CORRECTION

(see rules on reverse side)

Expected Spud Date. 8 month 7 day 87 year

API Number 15-195-21,919-00-00 150' NW of East

OPERATOR: License # 7875

* C NW SE Sec. 22 Twp. 11 S, Rg. 22 X West
* 2086 Ft. from South Line of Section
* 2086 Ft. from East Line of Section

Name Strata Energy Resources Corporation

Address 4101 Birch Street Suite #130

City/State/Zip Newport Beach, Ca, 92660

Contact Person Raymond A. Diaz

Phone 714-261-8181

(Note: Locate well on Section Plat on reverse side)

Nearest lease or unit boundary line feet
County Trego

CONTRACTOR: License # 5671

Lease Name Spalsbury Well # 3

Name Revlin Drig, Inc.

City/State Box 293 Russell, Ks. 67665

Ground surface elevation feet MSL

Domestic well within 330 feet: yes X no

Municipal well within one mile: yes X no

Well Drilled For: Well Class: Type Equipment:

X Oil Storage Infield X Mud Rotary

Gas Inj X Pool Ext Air Rotary

OWWO Expl Wildcat Cable

Depth to bottom of fresh water 95

Depth to bottom of usable water 875

Surface pipe by Alternate: 1 2 X

Surface pipe planned to be set 250

Conductor pipe required n/a

Projected Total Depth 4100 feet

Formation Arbuckle

If OWWO: old well info as follows:

Operator

Well Name

Comp Date Old Total Depth

I certify that well will comply with K.S.A. 55-101, et seq., plus eventually plugging hole to KCC specifications.

Date 7-28-87 Signature of Operator or Agent Paula J. Gibson Title Agent

For KCC Use:

Conductor Pipe Required feet; Minimum Surface Pipe Required 200 feet per Alt. X(2)

This Authorization Expires 1-7-88 Approved By Pat 7-31-87

*WAS: C-NW-SE 1980 FSL 1980 FEL


ORIG RCV'D

Must be filed with the K.C.C. five (5) days prior to commencing well
This card void if drilling not started within six (6) months of date received by K.C.C.

Important procedures to follow:

1. Notify District office before setting surface casing.
2. Set surface casing by circulating cement to the top.
3. File completion forms ACO-1 with K.C.C. within 120 days of well spud date, following instructions on ACO-1, side 1, and including copies of wireline logs.
4. Notify District office 48 hours prior to old well workover or re-entry.
5. Prior to filing Intent, prepare a proposed plugging plan in case well is D & A, then obtain approval of plan when calling district office prior to setting surface pipe.
6. Submit plugging report (CP-4) to K.C.C. after plugging is completed.
7. Obtain an approved injection docket number before disposing of salt water.
8. Notify K.C.C. within 10 days when injection commences or terminates.
9. If an alternate 2 completion, cement in the production pipe from below any usable water to surface within 120 days of spud date.

A Regular Section of Land 1 Mile = 5,280 Ft.

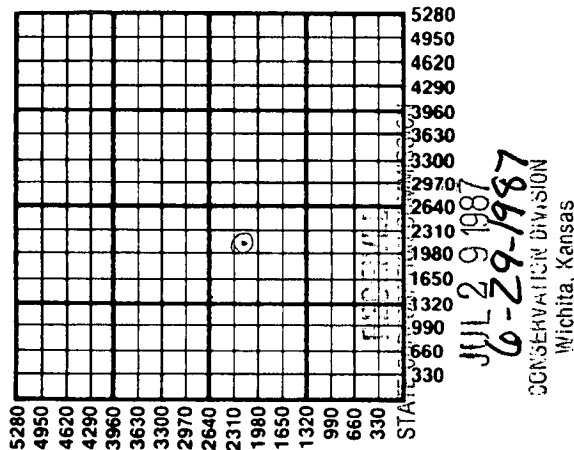

State Corporation Commission of Kansas
Conservation Division
200 Colorado Derby Building
Wichita, Kansas 67202-1212
(316) 263-3238