
NOTICE OF State of Kansas TO DRILL CARD MUST BE SIGNED (see rules on reverse side)


Starting D	ate:3	3/19/85		API Number 15- 195- 21, 691-00-00
		month day	year	☐ East
OPERATOR: License # 5198				N.E. N.E. N.E. Sec 9. Twp . 1.1. S, Rge . 2.2. West
Name A. Scott Ritchie				(location)
Address 125 N. Market, Suite 950				4950 Ft North from Southeast Corner of Section 330 Ft West from Southeast Corner of Section
City/State/Zip Wichita, Kansas 67202				330 Et West from Southeast Corner of Section
Contact Person Jeff Christian				(Note: Locate well on Section Plat on reverse side)
Phone 316/267-4375				Nearest lease or unit boundary line
				Nearest lease or unit boundary line feet.
CONTRACTOR: License #				County Trego Lease Name Stalnaker "A" Well# 1
NameMurfin Drilling Co				Lease NameScalliakel
City/StateWichita. Kansas				Domestic well within 330 feet: yes 🔀 no
Well Drill	ed For:	Well Class:	Type Equipment:	Municipal well within one mile : 🔲 yes 🐰 no
🔯 Oil	☐ Swd	☐ Infield	⊠ Mud Rotary	
☐ Gas	□ Inj		☐ Air Rotary	Depth to Bottom of fresh water
□ owwo	☐ Expl	☐ Wildcat	Cable	Lowest usable water formation Dakota
If OWWO: old weil info as follows:				Depth to Bottom of usable water900 feet
Operator				Surface pipe by Alternate: 1 7 2 [X]
Well Name				Surface pipe to be set
Comp Date Old Total Depth				Conductor pipe if any required feet
Comp Date				Conductor pipe if any required
Projected Formation at TD Arbuckle				This Authorization Expires 9/15/85
Expected Producing Formations Marmaton				This Authorization Expires 9/15/85 Approved By RCH/KCC 3/15/85
I certify that we will comply with K.S.A. 55-101, et seq., plus eventually plugging hole to K.C.C. specifications.				
Date 3/11/65. Signature of Operator or Agent of Christian. Title Geologist				

RECEIVED STATE CORPORATION COMMISSION 3-15-1985 MAR 1 5 1985

Must be filed with the K.C.C. five (5) days prior to commencing well This card void if drilling not started within six (6) months of date received by K.C.C.

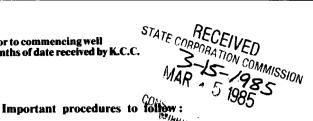

Wichita, Kansasa 1 Mile = 5.280 Ft.

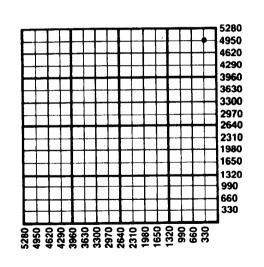

312

1. Notify District office before setting surface casing.

2. Set surface casing by circulating cement to the top.

and including copies of wireline logs.

- 3. File completion forms ACO-1 with K.C.C. within 90 days of well completion, following instructions on ACO-1, side 1,
- 4. Notify District office 48 hours prior to old well workover or re-entry.
- 5. Prior to plugging, prepare a plugging plan, then obtain agreement from the appropriate district office for an approved plugging plan.
- 6. Submit plugging report (CP-4) to K.C.C. after plugging is completed.
- 7. Obtain an approved injection docket number before disposing of salt water.
- 8. Notify K.C.C. within 10 days when injection commences or terminates.
- 9. If an alternate 2 completion, cement in the production pipe from below any usable water to surface within 120 days of spud date.

State Corporation Commission of Kansas
Conservation Division
200 Colorado Derby Building
Wichita, Kansas 67202
(316) 263-3238