

CARD MUST BE TYPED

State of Kansas  
NOTICE OF INTENTION TO DRILL

CARD MUST BE SIGNED

(see rules on reverse side)

Starting Date: 7/22/85  
month day year

API Number 15- 195-21, 727-00-00

OPERATOR: License # 5198  
Name A. Scott Ritchie  
Address 125 N. Market, Suite 950  
City/State/Zip Wichita, KS 67202  
Contact Person Rocky Milford  
Phone 316/267-4375

N/2 NE NW Sec. 30 Twp. 11 S, Rge. 22  East  West  
(location)

4950 Ft North from Southeast Corner of Section  
3300 Ft West from Southeast Corner of Section  
(Note: Locate well on Section Plat on reverse side)

CONTRACTOR: License # 6033  
Name Murfin Drilling Co.  
City/State Wichita, Kansas

Nearest lease or unit boundary line 330 feet.  
County Trego  
Lease Name Richardson "C" Well# 4

Well Drilled For: Well Class: Type Equipment:  
 Oil  Swd  Infield  Mud Rotary  
 Gas  Inj  Pool Ext.  Air Rotary  
 OWWO  Expl  Wildcat  Cable

Domestic well within 330 feet:  yes  no  
Municipal well within one mile:  yes  no

If OWWO: old well info as follows:

Operator  
Well Name  
Comp Date Old Total Depth  
Projected Total Depth 4000 feet  
Projected Formation at TD Arbuckle  
Expected Producing Formations Lans/KC, Marmaton

Depth to Bottom of fresh water 150 feet  
Lowest usable water formation Dakota  
Depth to Bottom of usable water 925 feet  
Surface pipe by Alternate: 1  2   
Surface pipe to be set 200 ~~360~~ feet  
Conductor pipe if any required feet  
Ground surface elevation est. 2300 feet MSL  
This Authorization Expires 11/16/85  
Approved By RCH/KCC 5/16/85

I certify that we will comply with K.S.A. 55-101, et seq., plus eventually plugging hole to K.C.C. specifications.

Date 5-15-85 Signature of Operator or Agent Robert A. Milford Title Geologist


MAC/MOHE 5-16-85

Must be filed with the K.C.C. five (5) days prior to commencing well  
 card void if drilling not started within six (6) months of date received by K.C.C.

5861-6  
 MAY 15 1985  
 5861-51-5  
 1 MILE

**Important procedures to follow :**

1. Notify District office before setting surface casing.
2. Set surface casing by circulating cement to the top.
3. File completion forms ACO-1 with K.C.C. within 90 days of well completion, following instructions on ACO-1, side 1, and including copies of wireline logs.
4. Notify District office 48 hours prior to old well workover or re-entry.
5. Prior to plugging, prepare a plugging plan, then obtain agreement from the appropriate district office for an approved plugging plan.
6. Submit plugging report (CP-4) to K.C.C. after plugging is completed.
7. Obtain an approved injection docket number before disposing of salt water.
8. Notify K.C.C. within 10 days when injection commences or terminates.
9. If an alternate 2 completion, cement in the production pipe from below any usable water to surface within 120 days of spud date.

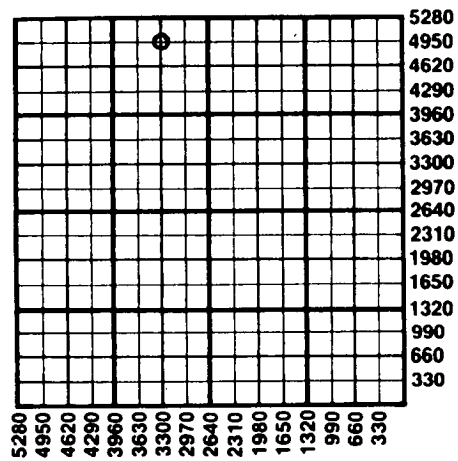

State Corporation Commission of Kansas  
 Conservation Division  
 200 Colorado Derby Building  
 Wichita, Kansas 67202  
 (316) 263-3238