

CARD MUST BE TYPED

State of Kansas
NOTICE OF INTENTION TO DRILL

CARD MUST BE SIGNED

(see rules on reverse side)

Starting Date: 7 10 84
month day year

API Number 15- 179-20,756-0000

OPERATOR: License # 6066

N/2 NW NW Sec 3 Twp 9 S, Rge 27
(location) East West

Name Skyline Petroleum

Address P. O. Box 70

City/State/Zip Hays, KS 67601

Contact Person Daniel F. Schippers

Phone (913) 625-0020

4950 Ft North from Southeast Corner of Section

4620 Ft West from Southeast Corner of Section

(Note: Locate well on Section Plat on reverse side)

CONTRACTOR: License # 5381

Name Big Springs Drilling

City/State Wichita, KS 67208

Nearest lease or unit boundary line 330 feet

County Sheridan

Lease Name Mosier 'A' Well# 8

Domestic well within 330 feet: yes no

Municipal well within one mile: yes no

Well Drilled For: Well Class: Type Equipment:

Oil Swd Infield Mud Rotary

Gas Inj Pool Ext. Air Rotary

OWWO Expl Wildcat Cable

If OWWO: old well info as follows:

Operator

Well Name

Comp Date Old Total Depth

Projected Total Depth 4050 feet

Projected Formation at TD Lansing

Expected Producing Formations Lansing

Depth to Bottom of fresh water 200 feet

Lowest usable water formation Dakota

Depth to Bottom of usable water 1450 feet

Surface pipe by Alternate: 1 2

Surface pipe to be set 250 feet

Conductor pipe if any required none feet

Ground surface elevation 2624 feet MSL

This Authorization Expires 1/9/85

Approved By 7/9/84

I certify that we will comply with K.S.A. 55-101, et seq., plus eventually plugging hole to K.C.C. specifications.

Date 7/6/84 Signature of Operator or Agent

Title Accountant

W H H O H E 7-9-84

Must be filed with the K.C.C. five (5) days prior to commencing well
This card void if drilling not started within six (6) months of date received by K.C.C.


RECEIVED
STATE CORPORATION COMMISSION

7-9-84

JUL 09 1984

A Regular Section of Land
1 Mile = 5,280 Ft.

CONSERVATION DIVISION
Wichita, Kansas

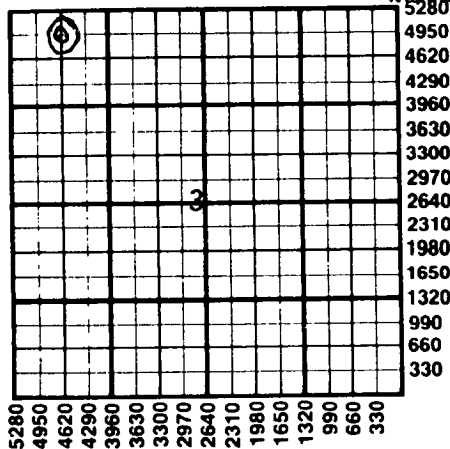

Important procedures to follow:

1. Notify District office before setting surface casing.
2. Set surface casing by circulating cement to the top.
3. File completion forms ACO-1 with K.C.C. within 90 days of well completion, following instructions on ACO-1, side 1, and including copies of wireline logs.
4. Notify District office 48 hours prior to old well workover or re-entry.
5. Prior to plugging, prepare a plugging plan, then obtain agreement from the appropriate district office for an approved plugging plan.
6. Submit plugging report (CP-4) to K.C.C. after plugging is completed.
7. Obtain an approved injection docket number before disposing of salt water.
8. Notify K.C.C. within 10 days when injection commences or terminates.
9. If an alternate 2 completion, cement in the production pipe from below any usable water to surface within 120 days of spud date.

State Corporation Commission of Kansas
Conservation Division
200 Colorado Derby Building
Wichita, Kansas 67202
(316) 263-3238