

STATE CORPORATION COMMISSION OF KANSAS
OIL & GAS CONSERVATION DIVISION

WELL COMPLETION OR RECOMPLETION FORM
ACO-1 WELL HISTORY

DESCRIPTION OF WELL AND LEASE

Operator: License # 7875
Name Strata Energy Resources Corporation
Address 4101 Birch St., Suite 130
Newport Beach, California 92660
Purchaser ~~Clear Creek~~
Wichita, KS
Operator Contact Person Raymond Diaz
Phone 714-261-8181
Contractor: License # 5302
Name Red Tiger Drilling Company
Wellsite Geologist Robert Wilson
Phone 303/794-6076

Designate Type of Completion

- New Well Re-Entry Workover
- Oil SWD Temp Abd
- Gas Inj Delayed Comp.
- Dry Other (Core, Water Supply etc.)

If OWWO: old well info as follows:

Operator
Well Name
Comp. Date Old Total Depth.....

WELL HISTORY

Drilling Method:

- Mud Rotary Air Rotary Cable

11/2/85 11/8/85
Spud Date Date Reached TD Completion Date
3,990'
Total Depth PBTD

Amount of Surface Pipe Set and Cemented at 253.12 feet
Multiple Stage Cementing Collar Used? Yes No
If yes, show depth set.....feet
If alternate 2 completion, cement circulated
from...TD.....feet depth to...w/.....SX cmt

API NO. 15-195-21,796-00-00

County Trego

NW/4 NE/4 SE/4 22 11S 22W East
Sec Twp Rge West

2310 Ft North from Southeast Corner of Section
990 Ft West from Southeast Corner of Section
(Note: Locate well in section plat below)


Lease Name Spalsbury Well # 1

Field Name New Field Sagelman, South

Producing Formation Marmaton

Elevation: Ground 2302 KB 2307

Section Plat

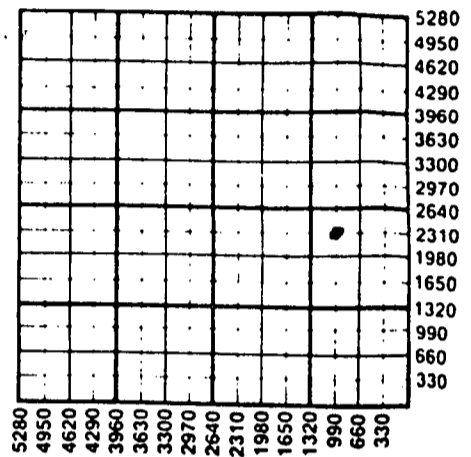

WATER SUPPLY INFORMATION

Disposition of Produced Water: Disposal
Docket # Repressuring

Questions on this portion of the ACO-1 call:
Water Resources Board (913) 296-3717

Source of Water:
Division of Water Resources Permit #.....
 Groundwater.....Ft North from Southeast Corner
(Well)Ft West from Southeast Corner
Sec Twp Rge East West
 Surface Water 4000 Ft North from Southeast Corner
(Stream, pond etc) 5100 Ft West from Southeast Corner
Sec 23 Twp 11 Rge 22 East West
Ethel Hillman, WaKeeney, Ks. 67672
 Other (explain).....
(purchased from city, R.W.D. #)

INSTRUCTIONS: This form shall be completed in duplicate and filed with the Kansas Corporation Commission, 200 Colorado Derby Building, Wichita, Kansas 67202, within 90 days after completion or recompletion of any well. Rule 82-3-130 and 82-3-107 apply.

Information on side two of this form will be held confidential for a period of 12 months if requested in writing and submitted with the form. See rule 82-3-107 for confidentiality in excess of 12 months. One copy of all wireline logs and drillers time log shall be attached with this form. Submit CP-4 form with all plugged wells. Submit CP-111 form with all temporarily abandoned wells.

All requirements of the statutes, rules and regulations promulgated to regulate the oil and gas industry have been fully complied with and the statements herein are complete and correct to the best of my knowledge.


Signature _____

Title President Date 4-3-86

Subscribed and sworn to before me this 3rd day of April 1986

Notary Public Amelia Allen

Date Commission Expires 2-5-88

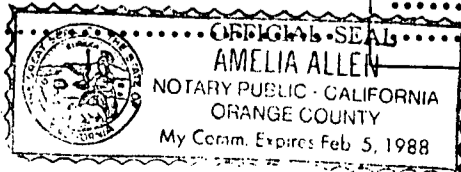

K.C.C. OFFICE USE ONLY
 Letter of Confidentiality Attached
 Wireline Log Received
 Drillers Timelog Received
Distribution
 KCC SWD/Rep NGPA
 KGS Plug Other (Specify)

SIDE TWO

Operator Name Strata Energy Resources Corporation Lease Name Spalsbury Well # 1

Sec. 22 Twp. 11S Rge. 22W County Trego

WELL LOG

INSTRUCTIONS: Show important tops and base of formations penetrated. Detail all cores. Report all drill stem tests giving interval tested, time tool open and closed, flowing and shut-in pressures, whether shut-in pressure reached static level, hydrostatic pressures, bottom hole temperature, fluid recovery, and flow rates if gas to surface during test. Attach extra sheet if more space is needed. Attach copy of log.

Drill Stem Tests Taken [X] Yes [] No
Samples Sent to Geological Survey [] Yes [X] No
Cores Taken [] Yes [X] No

Formation Description
[X] Log [] Sample

DST #1 391G-3930
Rec. 100' Mud Cut Oil
30-45-45-45
IH 2155 - FH 2134
FI 55 FF 66
SI 77 SF 77
IC 1218 FC 1185
Temp. 111 F.

Table with 3 columns: Name, Top, Bottom. Rows include Anhydrite, Base Anhydrite, Topeka, Heebner, Toronto, Lansing, B - KC, Marmaton, Conglomerate.

RELEASED
5-11-1987
MAY 11 1987

FROM CONFIDENTIAL

CASING RECORD, PERFORATION RECORD, TUBING RECORD, Date of First Production, Estimated Production, METHOD OF COMPLETION, Production Interval

STATE CORPORATION COMMISSION
APR 11 1986
CONSERVATION DIVISION
Wichita, Kansas

Flowing of gas: [X] Vented [] Sold [] Used on Lease [X] Closed in
[] Open Hole [X] Perforation
[] Other (Specify)
[] Dually Completed [] Commingled

3915-10
3925