Kansas Corporation Commission Oil & Gas Conservation Division

WELL PLUGGING APPLICATION

Please TYPE Form and File ONE Copy

Form CP-1 September 2003 This Form must be Typed Form must be Signed All blanks must be Filled

API # 15 - 007-01198 - 00 00 _____ (Identifier Number of this well). This must be listed for wells drilled since 1967; if no API # was issued, indicate original spud or completion date $\underline{1/15/1959}$ Well Operator: PETROLEUM PROPERTY SERVICES INC. ___ KCC License #: 31142 Address: 125 N. MARKET, SUITE 1251 (Operator's) ___ _{City:}_WICHITA State: _KANSAS ____ Contact Phone: (316) 265 - 3351 ____Zip Code: Lease: SKINNER 'D' Sec. 3 Two. 32 S. R. 15 East V West _____ Well #: 7 County:_BARBER SW Spot Location / QQQQ 330 ___ Feet (in exact footage) From North / 🗸 South (from nearest outside section corner) Line of Section (Not Lease Line) 1650 _ Feet (in exact footage) From 🦳 East / 🗹 West (from nearest outside section comer) Line of Section (Not Lease Line) Check One: V Oil Well Gas Well D&A Cathodic Water Supply Well ENHR Docket # _ Other: _____ Conductor Casing Size: ___ ____ Cemented with: Surface Casing Size:_8-5/8" _____ Cemented with: 225 Production Casing Size: 5-1/2" List (ALL) Perforations and Bridgeplug Sets: OPEN HOLE Elevation: 1979 Anhydrite Depth: 910' (GL.7 K.B.) TD. 4882 PBTD: (Stone Corral Formation) **✓** Good Junk in Hole Condition of Well: Poor Casing Leak Proposed Method of Plugging (attach a separate page if additional space is needed): As per 8/2007 instructions attached. RECEIVED Is Well Log attached to this application as required? Ves No Is ACO-1 filed? Yes No MAR 18 2009 If not explain why? BEFORE ACO-1. Plugging of this Well will be done in accordance with K.S.A. 55-101 et. seq. and the Rules and Regulations of the State Corporation Commission. List Name of Company Representative authorized to be in charge of plugging operations: LEON KUHN Phone: (785) 483 - 1559 Address: 125 N. MARKET, SUITE 1251, City / State: _WICHITA, KS 67202 Plugging Contractor: H-D OILFIELD SERVICE Address: P O BOX 87, BAZINE KS Proposed Date and Hour of Plugging (if known?): AS SOON AS AVAILABLE Payment of the Plugging Fee (K.A.R. 82-3-118) will be guaranteed by Operator or Agent Date: 3/17/09 __ Authorized Operator / Agent:

Mail to: KCC - Conservation Division, 130 S. Market - Room 2078, Wichita, Kansas 67202

Ron Schraeder

From: Steve Durrant [s.durrant@kcc.ks.gov]

Sent: Monday, August 06, 2007 1:10 PM

To: Ron Schraeder

Subject: SKINNER D #7 P & A

Bottom Plug:

a.) if no gas pressure at the surface, sand 51/2" to 4817' + 5sx. cmt with bailer.

b.) pump bottom with 200#s cotton seed hulls + 25 sx. cmt. displaced to bottom. (est. injection rate prior to pumping plug.)

c.) set CIBP@ 4800' + 2 sx. cmt with a bailer.

Top Plug

a.) Test casing after bottom plug has been set to 300#. Free pt. casing and pull to 1200'. Load hole w/gelled water and pump 50sx. cmt.(2nd. plug) Pull casing to 600'. Load hole with gelled water and pump 50 sx. cmt. (3rd.plug) pull casing to 330'.Load hole with gelled water and pump 50 sx. cmt. (4th plug) pull casing to 40' and circ. cmt. to surface.

b.) Test casing to 300 #, perf. casing at 1200' and circ. cmt. back to surface.


Thanks, SD

RECEIVED
MAR 1 8 2009
KCC WICHITA

RECEIVED KANSAS CORPORATION COMMISSION

AUG 15 2007

CONSERVATION DIVISION WICHITA, KS

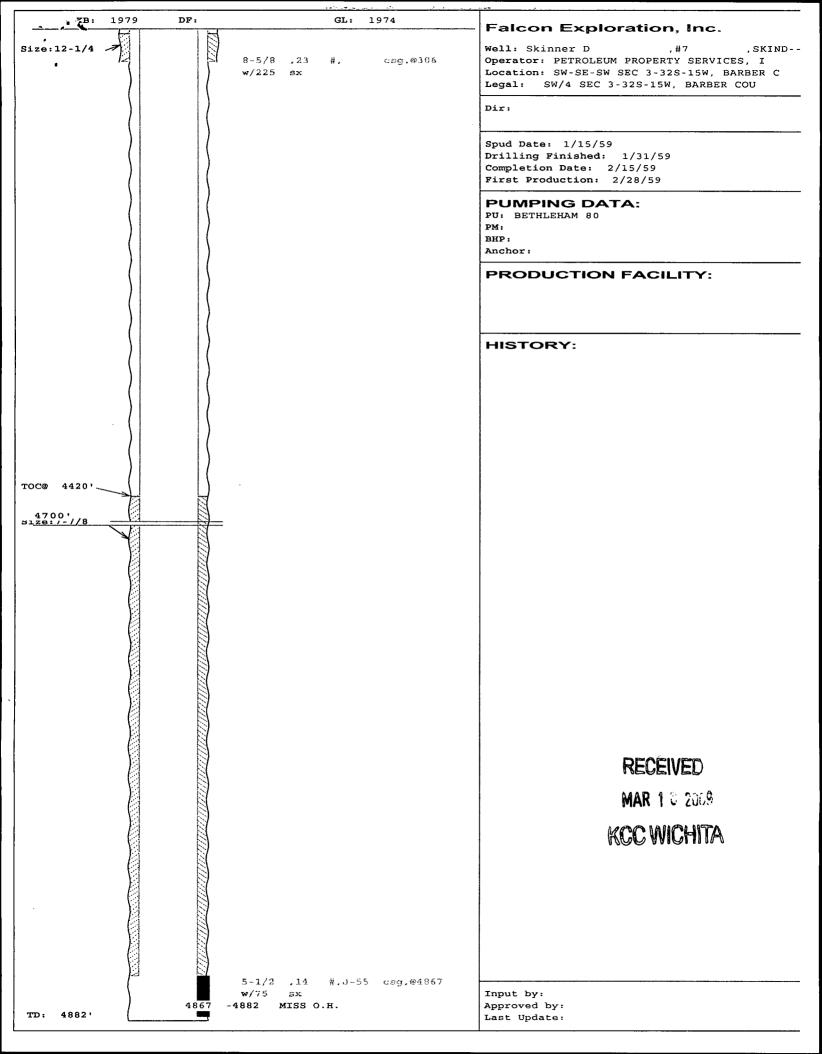



Kathleen Sebelius, Governor Thomas E. Wright, Chairman Michael C. Moffet, Commissioner Joseph F. Harkins, Commissioner

NOTICE OF RECEIPT OF WELL PLUGGING APPLICATION (CP-1)

PETROLEUM PROPERTY SERVICES, INC. 125 N MARKET SUITE 1251 WICHITA, KS 67202-1719 March 25, 2009

Re: SKINNER D #7

API 15-007-01198-00-00

3-32S-15W, 351 FSL 3661 FEL BARBER COUNTY, KANSAS

Dear Operator:

This letter is to notify you that the Conservation Division has received your plugging proposal, form CP-1, for the above well and has reviewed the proposal for completeness. The central office will now forward your CP-1 to the district office listed below for review of the proposed plugging method. Please contact the district office for approval of your proposed plugging method at least five (5) days before plugging the well, pursuant to K.A.R. 82-3-113(b). If a workover pit will be used during the plugging of the well it must be permitted. A CDP-1 form must be filed and approved prior to the use of the pit in accordance with K.A.R. 82-3-600.

The Conservation Division's review of form CP-1, either in the central or district office, does not include an inquiry into well ownership or the filing operator's legal right to plug the well. This notice in no way constitutes authorization to plug the above well by persons not having legal rights of ownership or interest in the well.

This notice is void after September 21, 2009. The CP-1 filing does not bring the above well into compliance with K.A.R. 82-3-111 with regard to the Commission's temporary abandonment requirements.

Sincerely,

Steve Bond

Steve Bond

Production Department Supervisor

District: #1 210 E Frontview, Suite A Dodge City, KS 67801 (620) 225-8888