


WELL PLUGGING RECORD

Give All Information Completely
Make Required Affidavit
Mail or Deliver Report to:
Conservation Division
State Corporation Commission
800 Bittling Building
Wichita, Kansas

NORTH

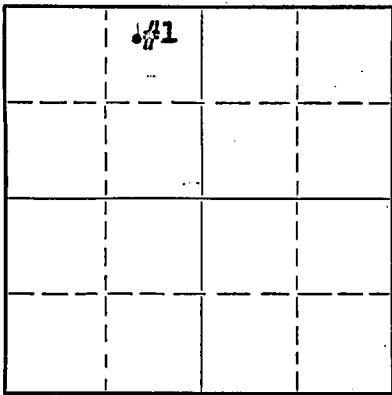

Locate well correctly on above Section Plat

TREGO County. Sec. 13 Twp. 11S Rge. (E) 23(W)
Location as "NE/CNW $\frac{1}{4}$ SW $\frac{1}{4}$ " or footage from lines Center of NW $\frac{1}{4}$ of NE $\frac{1}{4}$ of NW $\frac{1}{4}$
Lease Owner Amerada Pet. Corp.
Lease Name J. H. Carpenter Well No. 1
Office Address Box 2040 Tulsa, Okla.
Character of Well (completed as Oil, Gas or Dry Hole) Dry Hole.
Date well completed June 22, 19 51
Application for plugging filed June 22, 19 51
Application for plugging approved June 22, 19 51
Plugging commenced June 22, 19 51
Plugging completed June 23, 19 51
Reason for abandonment of well or producing formation DRY HOLE.

If a producing well is abandoned, date of last production 19...
Was permission obtained from the Conservation Division or its agents before plugging was commenced? Yes

Name of Conservation Agent who supervised plugging of this well Mr. Eldon Petty of Hays, Kansas.
Producing formation Depth to top Bottom Total Depth of Well 4003 Feet
Show depth and thickness of all water, oil and gas formations.

OIL, GAS OR WATER RECORDS

CASING RECORD

Formation	Content	From	To	Size	Put In	Pulled Out
				8-5/8" OD	202'	None.

Describe in detail the manner in which the well was plugged, indicating where the mud fluid was placed and the method or methods used in introducing it into the hole. If cement or other plugs were used, state the character of same and depth placed, from...feet to...feet for each plug set.

Filled hole with heavy rotary mud up to within 180' of top, set bridge plug at 180' down from top, mixed and dumped in 20 sacks of regular cement on plug, filled hole with heavy rotary mud up to within 40' of top of 8-5/8" surface casing in bottom of cellar, set plug 40' down from top, dumped in 1/2 sack cotton seed hulls on plug, mixed & dumped 10 sacks regular cement in hole, filling hole to top of 8-5/8" surface casing in bottom of cellar as required by State Plugger Mr. Eldon Petty of Hays, Kansas. Well plugged & abandoned as of 6/23/51.

RECEIVED
STATE CORPORATION COMMISSION
JUL 5 1951
CONSERVATION DIVISION
WICHITA, KANSAS

(If additional description is necessary, use BACK of this sheet)
Correspondence regarding this well should be addressed to Amerada Pet. Corp.
Address Box 2040
Tulsa, Oklahoma.

STATE OF Oklahoma COUNTY OF Tulsa, ss.
C. N. Rose (employee of owner) or (owner or operator) of the above-described well,
being first duly sworn on oath, says: That I have knowledge of the facts, statements, and matters herein contained and the log of the above-described well as filed and that the same are true and correct. So help me God.
(Signature) *C. N. Rose*

SUBSCRIBED AND SWORN to before me this 2 day of July, 1951
J. R. R... ..
Notary Public.

My commission expires January 17, 1955 23-5091-s 8-50-10M

PLUGGING
FILE SEC 13 T 11 R 23 W
BOOK PAGE 90 LINE 37

15-195-00340-00-00

Well No. 1
Farm J. H. Carpenter
Elevation
Location Center NW/4 NE/4 NW/4
330' South of North line
1650' East of West line
Section 13-11S-23W
Trego County, Kansas
Company Amerada Petroleum Corporation
Commenced Drlg. 6/8/51
Completed Drlg. 6/22/51
Contractor: Peel Bros., Inc.
Initial Production Dry Hole

CASING RECORD:	SIZE	WEIGHT	FEET	CEMENT	PERFORATIONS
	8-5/8"	24#	202	175	None


FORMATION

Shale	0	203
Anhydrite	203	1710
Lime & Shale	1710	2250
Shale	2250	2595
Lime & Shale	2595	2945
Lime	2945	3843
Cherty Conglomerate	3843	3938
Arbuckle	3938	4003
TOTAL DEPTH		4003'

SCHLUMBERGER TOPS

Heebner Shale	3457'
Lansing	3480'
Arbuckle	3960'
T.D.	4004'

Rotary tools used from 0 4003'

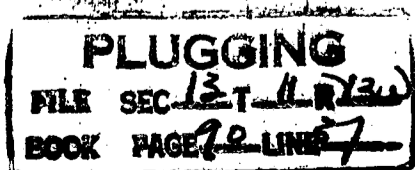

RECEIVED
STATE CONSERVATION COMMISSION
6-29-1951
JUN 29 1951
CONSERVATION DIVISION
Wichita, Kansas