


Give All Information Completely  
Make Required Affidavit  
Mail or Deliver Report to:  
Conservation Division  
State Corporation Commission  
211 No. Broadway  
Wichita, Kansas

WELL PLUGGING RECORD

NORTH

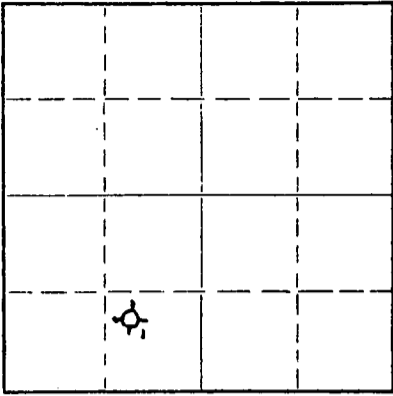

Locate well correctly on above Section Plat

Trego County, Sec. 13 Twp. 11S Rge. 23 (E) X (W)  
Location as "NE/CNW/SW" or footage from lines 50'N & 90'W of C/NW/SE/SW  
Lease Owner Helmerich & Payne, Inc.  
Lease Name Carpenter Well No. 1  
Office Address Box 558, Garden City, Kansas  
Character of Well (completed as Oil, Gas or Dry Hole) Dry Hole  
Date well completed 2-10-63 19  
Application for plugging filed 2-10-63 19  
Application for plugging approved 2-10-63 19  
Plugging commenced 2-10-63 19  
Plugging completed 2-10-63 19  
Reason for abandonment of well or producing formation Dry Hole

If a producing well is abandoned, date of last production - 19  
Was permission obtained from the Conservation Division or its agents before plugging was commenced? Yes

Name of Conservation Agent who supervised plugging of this well W. L. Nichols Moreland, Kansas  
Producing formation - Depth to top - Bottom - Total Depth of Well 3780 Feet  
Show depth and thickness of all water, oil and gas formations.

OIL, GAS OR WATER RECORDS

CASING RECORD

FORMATION	CONTENT	FROM	TO	SIZE	PUT IN	PULLED OUT
	Surface Pipe	0	210	8-5/8"	210	None

Describe in detail the manner in which the well was plugged, indicating where the mud fluid was placed and the method or methods used in introducing it into the hole. If cement or other plugs were used, state the character of same and depth placed, from \_\_\_\_\_ feet to \_\_\_\_\_ feet for each plug set.

3780 to 540 Heavy Rotary Mud  
540 to 480 Plug & 20 sacks pozmix cement  
480 to 180 Heavy Rotary Mud  
180 to 120 1/3 sack hulls & 20 sacks Pozmix cement  
120 to 30 Heavy Rotary Mud  
30 to 4 Wiper Plug & 10 sacks Pozmix cement  
4 to 0 Cellar

Plugging completed 2:30 PM February 10-1963

STATE CORPORATION COMMISSION  
2-12-1963  
FEB 12 1963

CONSERVATION DIVISION  
Wichita, Kansas

(If additional description is necessary, use BACK of this sheet)  
Name of Plugging Contractor Rains & Williams Oil Co.  
Address 412 Union Center Wichita, Kansas

STATE OF Kansas, COUNTY OF Finney, ss.  
T. E. Mort (employee of owner) or (owner or operator) of the above-described well, being first duly sworn on oath, says: That I have knowledge of the facts, statements, and matters herein contained and the log of the above-described well as filed and that the same are true and correct. So help me God.

(Signature) T. E. Mort  
Box 558, Garden City, Kansas (Address)

SUBSCRIBED AND SWORN TO before me this 11 day of February, 19 63

My commission expires July 1964 Robert N. Boyd Notary Public.



STATE

15-195-01116-00-00

ROTARY DRILLING LOG

Operator: Helmerich & Payne, Inc.  
NO. 1 CARPENTER  
C NW SE SW Section 13-11S-23W  
Trego County, Kansas

Contractor: Rains & Williamson  
Oil Co.  
COMMENCED : 2-1-63  
COMPLETED : 2-10-63

Remarks: Set 8-5/8" surface casing at 210' with 150 sacks Sunset cement

Formations:

Surface Clay	40'
Shale and Sand Streaks	130'
Sand	170'
Shale	578'
Sand	655'
Shale	820'
Sand	865'
Shale	1035'
Shale and Shells	1195'
Sand	1400'
Shale, Shells & Red Beds	1520'
Shale and Red Beds	1712'
Anhydrite	1752'
Shale and Shells	2300'
Shale and Lime	2375'
Lime and Shale	2695'
Shale and Lime	2915'
Lime and Shale	3180'
Shale and Lime	3295'
Lime and Shale	3554'
Lime	3780'

Rotary Total Depth (D & A) 3780'

RECEIVED  
STATE CORPORATION COMMISSION

FEB 14 1963

CONSERVATION DIVISION  
Wichita, Kansas

We certify the above log is true and correct to the best of our knowledge and belief.

RAINS & WILLIAMSON OIL CO.

*Wilson Rains*  
Wilson Rains  
Partner

Subscribed and sworn to before me, a Notary Public in and for the State of Kansas, County of Sedgwick, this 12th day of February, 1963.

*Sherry Gish*  
Sherry Gish Notary Public

My Commission Expires: Nov. 8, 1966