


WELL PLUGGING RECORD

Give All Information Completely  
Make Required Affidavit  
Mail or Deliver Report to:  
Conservation Division  
State Corporation Commission  
800 Bitting Building  
Wichita, Kansas

NORTH

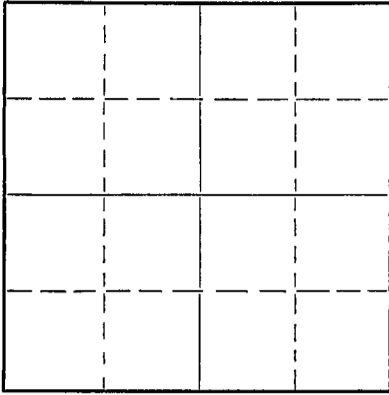

Locate well correctly on above  
Section Plat

Trego County, Sec. 25 Twp. 11S Rge. (E) 23 (W)  
Location as "NE/CNW $\frac{1}{4}$ SW $\frac{1}{4}$ " or footage from lines SE, SE, SW  
Lease Owner Jones, Shelburne & Farmer, Inc.  
Lease Name Mong Well No. 1  
Office Address Russell, Kansas  
Character of Well (completed as Oil, Gas or Dry Hole) Dry Hole  
Date well completed October 25 1950  
Application for plugging filed October 25 1950  
Application for plugging approved October 25 1950  
Plugging commenced October 25 1950  
Plugging completed October 25 1950  
Reason for abandonment of well or producing formation Dry Hole  
If a producing well is abandoned, date of last production Never Produced 19  
Was permission obtained from the Conservation Division or its agents before plugging was commenced? Yes

Name of Conservation Agent who supervised plugging of this well Eldon Petty  
Producing formation Depth to top Bottom Total Depth of Well 4,134 $\frac{1}{2}$  Feet  
Show depth and thickness of all water, oil and gas formations.

OIL, GAS OR WATER RECORDS

CASING RECORD

| Formation | Content | From | To | Size | Put In | Pulled Out |
|-----------|---------|------|----|------|--------|------------|
|           |         |      |    | 160' | 8 5/8" | None       |
|           |         |      |    |      |        |            |
|           |         |      |    |      |        |            |
Describe in detail the manner in which the well was plugged, indicating where the mud fluid was placed and the method or methods used in introducing it into the hole. If cement or other plugs were used, state the character of same and depth placed, from feet to feet for each plug set.

- Hole filled with heavy mud.
- Halliburton plug pushed to 155 feet.
- Fifteen sacks cement mixed and spotted on top of plug.
- Second Halliburton plug pushed to 30 feet.
- Ten sacks cement mixed and hole filled to top with same.

RECEIVED  
STATE CORPORATION COMMISSION  
10-28-1950  
OCT 28 1950  
CONSERVATION DIVISION  
WICHITA, KANSAS

(If additional description is necessary, use BACK of this sheet)


Correspondence regarding this well should be addressed to Jones, Shelburne & Farmer, Inc.  
Address Russell, Kansas

STATE OF Kansas, COUNTY OF Russell, ss.  
John O. Farmer (employee of owner) or (owner or operator) of the above-described well,  
being first duly sworn on oath, says: That I have knowledge of the facts, statements, and matters herein contained and the log of the above-described well as filed and that the same are true and correct. So help me God.

(Signature) *John O. Farmer*  
Russell, Kansas  
(Address)

SUBSCRIBED AND SWORN to before me this 26th day of October, 1950.  
*Phyllis Bethany*  
Notary Public.

My commission expires June 3, 1953

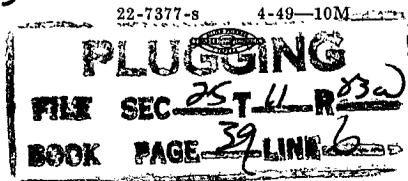

15-195-00249-00-00

Jones, Shelburne & Farmer, Inc.

Russell, Kansas

CONTRACTOR'S VERIFIED LOG

Operator JONES, SHELBURNE & FARMER, INC. Farm Name 15-195-00249-00-00 Well No 1

Location SE, SE, SW SECTION 25-11S-23W

Pool Name \_\_\_\_\_ County TREGO State KANSAS

Commencement Date October 14, 1950 Completion Date October 25, 1950

Log of Well

| Depth |                    | Formation             | Deviation from vertical (degrees) | Remarks |
|-------|--------------------|-----------------------|-----------------------------------|---------|
| From  | To                 |                       |                                   |         |
| •     | 160                | Shale                 |                                   |         |
| 160   | 640                | Shale and shells      |                                   |         |
| 640   | 910                | Shale and sand        |                                   |         |
| 910   | 1060               | Shale and shells      |                                   |         |
| 1060  | 1120               | Sand                  |                                   |         |
| 1120  | 1805               | Shale and shells      |                                   |         |
| 1805  | 1855               | Anhydrite             |                                   |         |
| 1855  | 2465               | Shale and shells      |                                   |         |
| 2465  | 2795               | Lime and shale        |                                   |         |
| 2795  | 2960               | Shale and shells      |                                   |         |
| 2960  | 3660               | Lime and shale        |                                   |         |
| 3660  | 3965               | Lime                  |                                   |         |
| 3965  | 3945               | Lime and shale        |                                   |         |
| 3995  | 4065               | Lime and chert        |                                   |         |
| 4065  | 4134 $\frac{1}{2}$ | Lime                  |                                   |         |
|       | 4134 $\frac{1}{2}$ | Total Depth           |                                   |         |
|       |                    | <u>TOPS</u>           |                                   |         |
|       | 1805               | Anhydrite             |                                   |         |
|       | 3603               | Heebner               |                                   |         |
|       | 3638               | Kansas City - Lansing |                                   |         |
|       | 4064               | Arbuckle              |                                   |         |

RECEIVED  
STATE COMMISSION  
10-28-1950  
OCT 28 1950

PLANNING  
FMS SEC 25 T 11 R 23W  
LOOK PAGE 39 LINE 6

