

State

15-195-01335-00-00


STATE OF KANSAS  
STATE CORPORATION COMMISSION

WELL PLUGGING RECORD  
OR  
FORMATION PLUGGING RECORD

Strike out upper line  
when reporting plugging  
off formations.

Give All Information Completely  
Make Required Affidavit  
Mail or Deliver Report to:  
Conservation Division  
State Corporation Commission,  
800 Bitting Building,  
Wichita, Kansas

NORTH

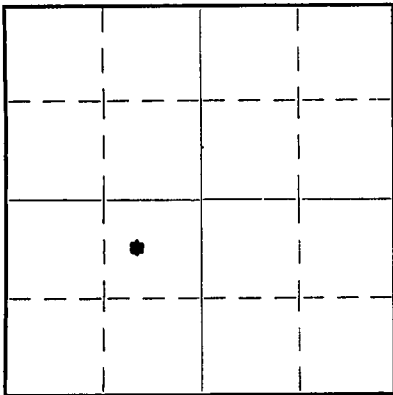

Locate well correctly on above  
Section Plat

Trego County. Sec. 26 Twp. 11s. Rge. 23w (E) (W)  
Location as "NE 1/4 NW 1/4 SW 1/4" or footage from lines 1650 W-1 990 N-1 S.W. 1/4  
Lease Owner Max Cohen  
Lease Name Howett Well No. 1  
Office Address Petroleum Building Wichita Kansas  
Character of Well (Completed as Oil, Gas or Dry Hole) Dry Hole  
Date, well completed Feb 26 1943  
Application for plugging filed Feb 26 1943  
Application for plugging approved Feb 26 1943  
Plugging Commenced Feb 27 1943  
Plugging Completed Feb 27 1943  
Reason for abandonment of well or producing formation

If a producing well is abandoned, date of last production 193...  
Was permission obtained from the Conservation Division or its agents before plugging was commenced? Yes

Name of Conservation Agent who supervised plugging of this well Alexander  
Producing formation Depth to top Bottom Total Depth of Well 4078 Feet  
Show depth and thickness of all water, oil and gas formations.

OIL, GAS OR WATER RECORDS

CASING RECORD


Formation	Content	From	To	Size	Put In	Pulled Out
				10 3/4"	97'	None

Describe in detail the manner in which the well was plugged, indicating where the mud fluid was placed and the method or methods used in introducing it into the hole. If cement or other plugs were used, state the character of same and depth placed, from...feet to ...feet for each plug set.

Filled with Heavy Mud from Bottom to 115'

Set Plug and filled with 15 Sacks Cement,

Very Heavy Mud to 10' then put in 8X Sacks of Cement,  
at top of Surface,

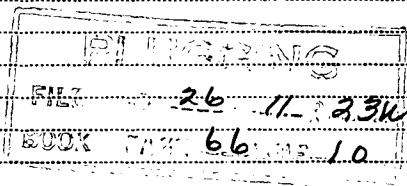

3-9-1943

(If additional description is necessary use BACK of this sheet)

Correspondence regarding this well should be addressed to Max Cohen  
Address Petroleum Building, Wichita Kansas

STATE OF Kansas, COUNTY OF Reno, SS.  
Clyde Pulse (employee of owner) or (owner or operator) of the above-described well,  
being first duly sworn on oath, says: That I have knowledge of the facts, statements, and matters herein contained and the log of the above-described well as filed and that the same are true and correct. So help me God.

(Signature) [Signature]

301 Hoke Building, Hutchinson Kansas  
(Address)

SUBSCRIBED AND SWORN to before me this 2nd day of March, 1943.

My commission expires Sept. 9, 1946

Log Howett Well #1, Drilled By Max Cohen, Sec 26 Twp 11s Range 23w Trego Co.  
 Drilled By Pulse Drilling Co, Inc.  
 Commenced Jan 10 1943 Completed, Feb 26 1943.

Surface	8	45
Shale & sand		86
Shale & Shells,		1110
Sand		1150
Shale & Shells		1350
Sand		1560
Red Rock		1820
Lime		1870
Shale (sticky)		1940
Shale & Shells		2085
Broken lime		2395
Lime		2525
Shale & Shells		2555
Lime		2755
Shale & Shells		2795
Lime & Shale breaks		3015
Lime		3045
Shale & Shells		3075
Shale		3100
Shale & Shells		3176
Shale		3200
Lime		3205
Sandy Lime		3262
Shale (sticky)		3370
Lime & Shale Breaks		3490
Shale		3510
Lime		3524
Shale		3585
Lime		3651
Shale (cored)	0	3657
Lime		3726
Lime & Shale breaks		3766
Lime		3845
Lime & Red rock breaks		3875
Lime		3880
Shale & Red rock		3895
Shale & Shells		3939
Lime		3963
Shale		3972
Lime		3980
Chert		3986
Lime & Shale breaks		4003
Lime		4015
Lime & Shale breaks		4062
Dolomite		4076
Lime		4078' T.D. Dry & abandoned,

3-9-1943

Casing Record,

97' 10 3/4" S.H. Casing, Cemented 50 sks,

26 11 23W  
 66 10