

For KCC Use: 592009  
 Effective Date: 4  
 District # \_\_\_\_\_  
 SGA?  Yes  No

KANSAS CORPORATION COMMISSION  
 OIL & GAS CONSERVATION DIVISION

Form C-1  
 October 2007  
**Form must be Typed**  
**Form must be Signed**  
**All blanks must be Filled**

**NOTICE OF INTENT TO DRILL**

Must be approved by KCC five (5) days prior to commencing well

Expected Spud Date: May 20, 2009  
month day year

OPERATOR: License# 6931  
 Name: Bowman Oil Company  
 Address 1: 805 Codell Road  
 Address 2: \_\_\_\_\_  
 City: Codell State: Kansas Zip: 67663 + \_\_\_\_\_  
 Contact Person: Louis "Don" Bowman or William "Bill" Bowman  
 Phone: 785-434-2286 M-F

CONTRACTOR: License# 33237  
 Name: Anderson Drilling Company

|   |                                   |  |
|---|-----------------------------------|--|
| <b>Well Drilled For:</b>                            | <b>Well Class:</b>                | <b>Type Equipment:</b>                         |
| <input checked="" type="checkbox"/> Oil             | <input type="checkbox"/> Enh Rec  | <input checked="" type="checkbox"/> Mud Rotary |
| <input type="checkbox"/> Gas                        | <input type="checkbox"/> Storage  | <input type="checkbox"/> Air Rotary            |
|   | <input type="checkbox"/> Disposal | <input type="checkbox"/> Cable                 |
| <input type="checkbox"/> Seismic ; _____ # of Holes | <input type="checkbox"/> Wildcat  |  |
| <input type="checkbox"/> Other: _____               | <input type="checkbox"/> Other    |  |

If OWWO: old well information as follows:  
 Operator: N/A  
 Well Name: N/A  
 Original Completion Date: N/A Original Total Depth: N/A

Directional, Deviated or Horizontal wellbore?  Yes  No  
 If Yes, true vertical depth: \_\_\_\_\_  
 Bottom Hole Location: \_\_\_\_\_  
 KCC DKT #: \_\_\_\_\_

Spot Description: 3260' FEL 1433' FEL of G6 T76 R20W  
 SE SW NE Sec. 6 Twp. 7 S. R. 20  E  W  
(a/a/a/a)  
3,260 feet from  N /  S Line of Section  
1,433 feet from  E /  W Line of Section

Is SECTION:  Regular  Irregular?  
 (Note: Locate well on the Section Plat on reverse side)  
 County: Rooks County, Kansas

Lease Name: D LeSage Well #: 2  
 Field Name: Solohow Southeast

Is this a Prorated / Spaced Field?  Yes  No  
 Target Formation(s): Arbuckle

Nearest Lease or unit boundary line (in footage): 1433' FEL  
 Ground Surface Elevation: Approximately 2209' KB feet MSL

Water well within one-quarter mile:  Yes  No  
 Public water supply well within one mile:  Yes  No

Depth to bottom of fresh water: Approximately 150'  
 Depth to bottom of usable water: Approximately 1100'

Surface Pipe by Alternate:  I  II  
 Length of Surface Pipe Planned to be set: Approximately 200'

Length of Conductor Pipe (if any): N/A  
 Projected Total Depth: Approximately 3750'

Formation at Total Depth: Arbuckle  
 Water Source for Drilling Operations:  
 Well  Farm Pond  Other: \_\_\_\_\_

DWR Permit #: \_\_\_\_\_  
 (Note: Apply for Permit with DWR )

Will Cores be taken?  Yes  No  
 If Yes, proposed zone: \_\_\_\_\_

**AFFIDAVIT**

The undersigned hereby affirms that the drilling, completion and eventual plugging of this well will comply with K.S.A. 55 et. seq.  
 It is agreed that the following minimum requirements will be met:

1. Notify the appropriate district office **prior** to spudding of well;
2. A copy of the approved notice of intent to drill **shall be** posted on each drilling rig;
3. The minimum amount of surface pipe as specified below **shall be set** by circulating cement to the top; in all cases surface pipe **shall be set** through all unconsolidated materials plus a minimum of 20 feet into the underlying formation.
4. If the well is dry hole, an agreement between the operator and the district office on plug length and placement is necessary **prior to plugging**;
5. The appropriate district office will be notified before well is either plugged or production casing is cemented in;
6. If an ALTERNATE II COMPLETION, production pipe shall be cemented from below any usable water to surface within **120 DAYS** of spud date.  
 Or pursuant to Appendix "B" - Eastern Kansas surface casing order #133,891-C, which applies to the KCC District 3 area, alternate II cementing must be completed within 30 days of the spud date or the well shall be plugged. **In all cases, NOTIFY district office** prior to any cementing.

I hereby certify that the statements made herein are true and correct to the best of my knowledge and belief.

Date: April 30, 2009 Signature of Operator or Agent: Corneil Austin Title: Agent for Bowman Oil Company

**For KCC Use ONLY**  
 API # 15 - 163-23803-00-00  
 Conductor pipe required None feet  
 Minimum surface pipe required 200 feet per ALT.  I  II  
 Approved by: put 5-4-2009  
 This authorization expires: 5-4-2010  
(This authorization void if drilling not started within 12 months of approval date.)  
 Spud date: \_\_\_\_\_ Agent: \_\_\_\_\_

**Remember to:**

- File Drill Pit Application (form CDP-1) with Intent to Drill;
- File Completion Form ACO-1 within 120 days of spud date;
- File acreage attribution plat according to field proration orders;
- Notify appropriate district office 48 hours prior to workover or re-entry;
- Submit plugging report (CP-4) after plugging is completed (within 60 days);
- Obtain written approval before disposing or injecting salt water.
- If this permit has expired (See: authorized expiration date) please check the box below and return to the address below.

Well Not Drilled - Permit Expired Date: \_\_\_\_\_  
 Signature of Operator or Agent: \_\_\_\_\_

KANSAS CORPORATION COMMISSION

MAY 04 2009

RECEIVED

6  
7  
20  
E  
W

**IN ALL CASES PLOT THE INTENDED WELL ON THE PLAT BELOW**

*Plat of acreage attributable to a well in a prorated or spaced field*

**If the intended well is in a prorated or spaced field, please fully complete this side of the form.** If the intended well is in a prorated or spaced field complete the plat below showing that the well will be properly located in relationship to other wells producing from the common source of supply. Please show all the wells and within 1 mile of the boundaries of the proposed acreage attribution unit for gas wells and within 1/2 mile of the boundaries of the proposed acreage attribution unit for oil wells.

API No. 15 - 163-23803-00-00  
 Operator: Bowman Oil Company  
 Lease: D LeSage  
 Well Number: 2  
 Field: Solobow Southeast

Location of Well: County: Rooks County, Kansas  
 3,260 feet from  N /  S Line of Section  
 1,433 feet from  E /  W Line of Section  
 Sec. 6 Twp. 7 S. R. 20  E  W

Number of Acres attributable to well: \_\_\_\_\_  
 QTR/QTR/QTR/QTR of acreage: \_\_\_\_\_ - SE - SW - NE


Is Section:  Regular or  Irregular

**If Section is irregular, locate well from nearest corner boundary.**


Section corner used:  NE  NW  SE  SW

**PLAT**

*(Show location of the well and shade attributable acreage for prorated or spaced wells.)  
 (Show footage to the nearest lease or unit boundary line.)*

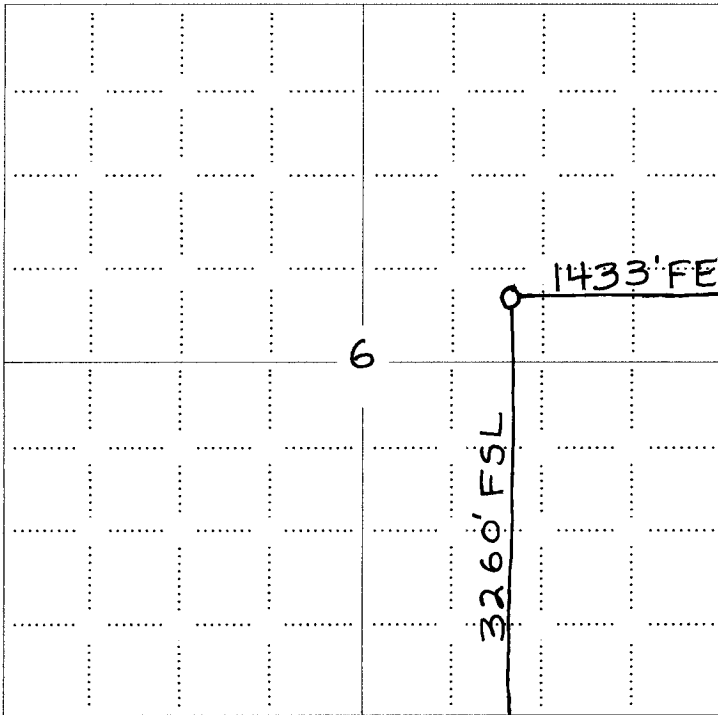

KANSAS CORPORATION COMMISSION  
 MAY 04 2009  
 RECEIVED

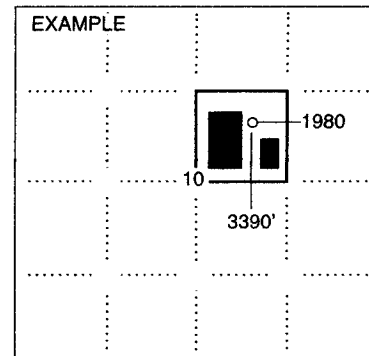

SEWARD CO.

**NOTE: In all cases locate the spot of the proposed drilling locaton.**


**In plotting the proposed location of the well, you must show:**

1. The manner in which you are using the depicted plat by identifying section lines, i.e. 1 section, 1 section with 8 surrounding sections, 4 sections, etc.
2. The distance of the proposed drilling location from the south / north and east / west outside section lines.
3. The distance to the nearest lease or unit boundary line (in footage).
4. If proposed location is located within a prorated or spaced field a certificate of acreage attribution plat must be attached: (CO-7 for oil wells; CG-8 for gas wells).

**KANSAS CORPORATION COMMISSION  
OIL & GAS CONSERVATION DIVISION  
APPLICATION FOR SURFACE PIT**

Form CDP-1  
April 2004  
Form must be Typed

*Submit in Duplicate*
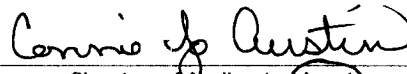
|  |  |  |                     |
|--|--|--|---------------------|
| Operator Name: <b>Bowman Oil Company</b>   |  | License Number: <b>6931</b>  |                     |
| Operator Address: <b>805 Codell Road</b>   |  | <b>Codell</b>  | Kansas <b>67663</b> |
| Contact Person: <b>Louis "Don" Bowman or William "Bill" Bowman</b>   |  | Phone Number: <b>785-434-2286 M-F</b>  |                     |
| Lease Name & Well No.: <b>D LeSage 2</b>   |  | Pit Location (QQQQ):<br><b>SE</b> <b>SW</b> <b>NE</b><br>Sec. <b>6</b> Twp. <b>7</b> R. <b>20</b> <input type="checkbox"/> East <input checked="" type="checkbox"/> West<br><b>3,260</b> Feet from <input type="checkbox"/> North / <input checked="" type="checkbox"/> South Line of Section<br><b>1,433</b> Feet from <input checked="" type="checkbox"/> East / <input type="checkbox"/> West Line of Section<br><b>Rooks County, Kansas</b> County |                     |
| Type of Pit:<br><input type="checkbox"/> Emergency Pit <input type="checkbox"/> Burn Pit<br><input type="checkbox"/> Settling Pit <input checked="" type="checkbox"/> Drilling Pit<br><input type="checkbox"/> Workover Pit <input type="checkbox"/> Haul-Off Pit<br><small>(If WP Supply API No. or Year Drilled)</small> |  | Pit is:<br><input checked="" type="checkbox"/> Proposed <input type="checkbox"/> Existing<br>If Existing, date constructed: _____<br>Pit capacity:<br><b>500</b> (bbls)  |                     |
| Is the pit located in a Sensitive Ground Water Area? <input type="checkbox"/> Yes <input checked="" type="checkbox"/> No   |  | Chloride concentration: _____ mg/l<br><small>(For Emergency Pits and Settling Pits only)</small>   |                     |
| Is the bottom below ground level?<br><input type="checkbox"/> Yes <input type="checkbox"/> No  |  | Artificial Liner?<br><input checked="" type="checkbox"/> Yes <input type="checkbox"/> No   |                     |
| How is the pit lined if a plastic liner is not used?   |  |  |                     |
| Pit dimensions (all but working pits): <u>40</u> Length (feet) <u>12</u> Width (feet) <input type="checkbox"/> N/A: Steel Pits<br>Depth from ground level to deepest point: <u>6</u> (feet) <input type="checkbox"/> No Pit  |  |  |                     |
| If the pit is lined give a brief description of the liner material, thickness and installation procedure.<br><b>Standard Black Plastic</b>   |  | Describe procedures for periodic maintenance and determining liner integrity, including any special monitoring.<br><b>Daily Visual Inspection</b><br><div style="text-align: right;"> <b>KANSAS CORPORATION COMMISSION</b><br/> <b>MAY 04 2009</b><br/> <b>RECEIVED</b> </div>   |                     |
| Distance to nearest water well within one-mile of pit<br><u>Approx. 3400</u> feet    Depth of water well <u>28</u> feet  |  | Depth to shallowest fresh water <u>20</u> feet.<br>Source of information:<br><input checked="" type="checkbox"/> measured <input type="checkbox"/> well owner <input type="checkbox"/> electric log <input type="checkbox"/> KDWR  |                     |
| <b>Emergency, Settling and Burn Pits ONLY:</b><br>Producing Formation: _____<br>Number of producing wells on lease: _____<br>Barrels of fluid produced daily: _____<br>Does the slope from the tank battery allow all spilled fluids to flow into the pit? <input type="checkbox"/> Yes <input type="checkbox"/> No        |  | <b>Drilling, Workover and Haul-Off Pits ONLY:</b><br>Type of material utilized in drilling/workover: <u>Rotary Drilling Mud</u><br>Number of working pits to be utilized: <u>3</u><br>Abandonment procedure: <u>Waste will be transferred, Pit will be allowed to Air Dry, Then Pit will be filled back to Ground Level.</u><br>Drill pits must be closed within 365 days of spud date.  |                     |
| I hereby certify that the above statements are true and correct to the best of my knowledge and belief.  |  |  |                     |
| <u>April 30, 2009</u><br>Date  |  | <br>Signature of Applicant or Agent  |                     |
| <b>KCC OFFICE USE ONLY</b>   |  |  |                     |
| Date Received: <u>5/4/09</u> Permit Number: _____  |  | Steel Pit <input type="checkbox"/> RFAC <input type="checkbox"/> RFAS <input type="checkbox"/>   |                     |
| Permit Date: <u>5/04/09</u> Lease Inspection: <input type="checkbox"/> Yes <input checked="" type="checkbox"/> No  |  |  |                     |

15-103-23803-00-00

Mail to: KCC - Conservation Division, 130 S. Market - Room 2078, Wichita, Kansas 67202