


15-051-21171-00-00

FORM CP-4

STATE OF KANSAS  
STATE CORPORATION COMMISSION  
CONSERVATION DIVISION  
P. O. BOX 17027  
WICHITA, KANSAS 67217

WELL PLUGGING RECORD

Ellis County. Sec. 16 Twp. 11S Rge. 20 (W)  
Location as "NE/CNWxSWx" or footage from lines C SE NE SE  
Lease Owner The Maurice L. Brown Company  
Lease Name SCHOENTHALER Well No. #1  
Office Address 1500 Vickers KSB&T Building, Wichita, Ks. 67202  
Character of Well (completed as Oil, Gas or Dry Hole) Dry Hole  
Date well completed April 5, 1976  
Application for plugging filed (verbally) April 5, 1976  
Application for plugging approved (verbally) April 5, 1976  
Plugging commenced April 5, 1976  
Plugging completed April 5, 1976  
Reason for abandonment of well or producing formation No commercial quantity of oil or gas encountered.  
If a producing well is abandoned, date of last production 19  
Was permission obtained from the Conservation Division or its agents before plugging was commenced? Yes

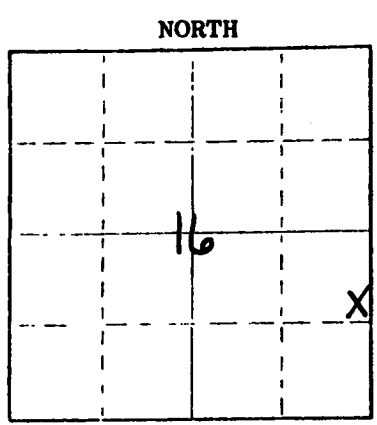

Locate well correctly on above Section Plat

Name of Conservation Agent who supervised plugging of this well Leo Massey  
Producing formation \_\_\_\_\_ Depth to top \_\_\_\_\_ Bottom \_\_\_\_\_ Total Depth of Well 3610'  
Show depth and thickness of all water, oil and gas formations.

OIL, GAS OR WATER RECORDS				CASING RECORD		
FORMATION	CONTENT	FROM	TO	SIZE	PUT IN	PULLED OUT
				8 5/8"	268'	none

Describe in detail the manner in which the well was plugged, indicating where the mud fluid was placed and the method or methods used in introducing it into the hole. If cement or other plugs were used, state the character of same and depth placed, from \_\_\_\_\_ feet to \_\_\_\_\_ feet for each plug set.

1st Plug was Set @ 550' with 50 sx. cement  
2nd Plug was Set @ 250' with 25 sx. cement  
3rd Plug was Set @ 40' with 10 sx. cement

(If additional description is necessary, use BACK of this sheet)  
Name of Plugging Contractor Abercrombie Drilling, Inc.  
Address 801 Union Center, Wichita, Kansas: 67202


STATE OF KANSAS COUNTY OF SEDGWICK  
Jerry A. Langrehr-Exec. V.P. (employee of owner) or (owner or operator) of the above-described

well, being first duly sworn on oath, says: That I have knowledge of the facts, statements, and matters herein contained and the log of the above-described well as filed and that the same are true and correct. So help me God.

(Signature) Jerry A. Langrehr  
801 Union Center, Wichita, Ks. 67202  
(Address)

Subscribed and sworn to before me this 7th day of April, 1976

My commission expires February 18, 1980 Diane Steincamp Notary Public.

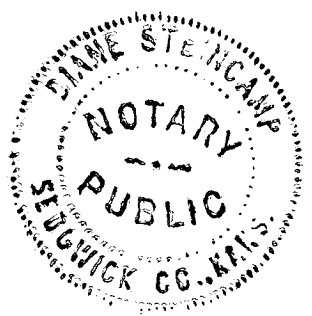

4-8-1976  
APR 08 1976

Conservation Division  
Wichita, Kansas

OPERATOR: The Maurice L. Brown Company  
 CONTRACTOR: Abercrombie Drilling, Inc.  
 WELL NAME: SCHOENTHALER #1  
 LOCATION: C SE NE SE Section 16-11S-20W  
 Ellis County, Kansas  
 SPUD DATE: March 28, 1976  
 COMPLETION DATE: April 5, 1976

0	75	Clay & Rock
75	268	Shale
268	635	Shale & Sand
635	710	Sand
710	960	Shale
960	1180	Sand
1180	1476	Shale
1476	1513	Anhydrite
1513	2317	Shale
2317	3240	Lime & Shale
3240	3365	Shale & Lime
3365	3610	Lime
	3610	Rotary Total Depth

SAMPLE TOPS:

Anhydrite 1476'  
 B/Anhydrite 1513'

Cut 268' of 12 1/4" hole. Ran 7 jts. 8 5/8" 28# casing, Set @ 268' K.B. Cemented with 200 sx. cement, 3% ca. cl. 6% gel. Cement circulated. Welded all collars. Plug was down @ 1:15 p.m. March 28, 1976.  
 Plugged and Abandoned: 1st Plug was Set @550' with 50 sx. cement; 2nd Plug was Set @250' with 25 sx. cement; 3rd Plug was Set @40' with 10 sx. cement. State Plugger: Leo Massey. Plug was down @ 8:30 a.m. April 5, 1976.

STATE OF KANSAS )  
 ) SS  
 COUNTY OF SEDGWICK )

Jerry A. Langrehr-Exec. Vice President of Abercrombie Drilling, Inc., does hereby state that the above and foregoing is a true and correct copy of the log of the SCHOENTHALER #1 C SE NE SE Section 16-11S-20W, Ellis County, Kansas.


ABERCROMBIE DRILLING, INC.

By: Jerry A. Langrehr  
 Jerry A. Langrehr-Exec. Vice President

Subscribed and sworn to before me, a Notary Public, in and for the aforesaid county and state as of this 7th day of April, 1976.

Diane Steincamp  
 Diane Steincamp - Notary Public

My Commission Expires: February 18, 1980

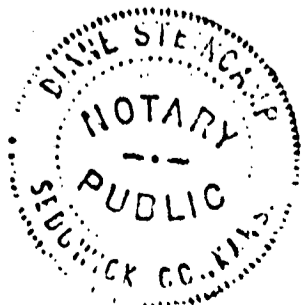

4-8-1976  
 RECEIVED