


Give All Information Completely
Make Required Affidavit
Mail or Deliver Report to:
Conservation Division
State Corporation Commission
212 No. Market
Wichita, Kansas

WELL PLUGGING RECORD

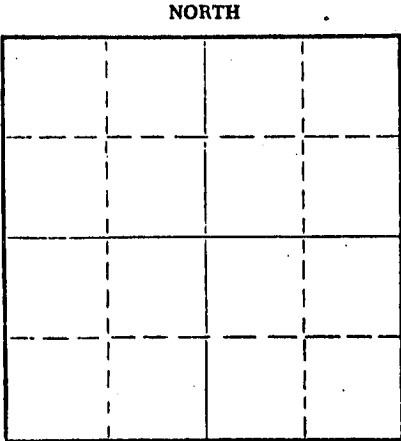

Locate well correctly on above
Section Plat

Ellis County, Sec. 17 Twp. 11 Rge. 20 (E) W (W)
Location as "NE/CNW/SW" or footage from lines NW SE NW
Lease Owner D & D Drilling Company, Inc.
Lease Name Denning Well No. #1
Office Address 307 Schweiter Bldg., Wichita, Kansas 67202
Character of Well (completed as Oil, Gas or Dry Hole) Dry Hole
Date well completed 2-15-1967
Application for plugging filed 2-15-1967
Application for plugging approved 2-15-1967
Plugging commenced 2-15-1967
Plugging completed 2-15-1967
Reason for abandonment of well or producing formation Dry Hole

If a producing well is abandoned, date of last production 19
Was permission obtained from the Conservation Division or its agents before plugging was commenced? Yes

Name of Conservation Agent who supervised plugging of this well Leo Massey
Producing formation _____ Depth to top _____ Bottom _____ Total Depth of Well _____ Feet
Show depth and thickness of all water, oil and gas formations.

OIL, GAS OR WATER RECORDS

CASING RECORD

FORMATION	CONTENT	FROM	TO	SIZE	PUT IN	PULLED OUT
Surface Pipe				8 5/8"	181'	

Describe in detail the manner in which the well was plugged, indicating where the mud fluid was placed and the method or methods used in introducing it into the hole. If cement or other plugs were used, state the character of same and depth placed, from _____ feet to _____ feet for each plug set.

Filled hole with rotary mud to a depth of 540' where 1st. plug was set using 25 sacks cement. Filling hole with rotary mud to a depth of 180' where 2nd. plug was set using 20 sacks cement. Rotary mud was used to fill hole to a depth of 40' where 3rd. plug was set using 8 sacks cement and 2 sacks in rat hole.

(If additional description is necessary, use BACK of this sheet)
Name of Plugging Contractor L. J. Dreiling & Sons, Inc.
Address Route 2, Victoria, Kansas 67671

STATE OF KANSAS, COUNTY OF ELLIS, ss.
I, Leo F. Dreiling (employee of owner) or (owner or operator) of the above-described well, being first duly sworn on oath, says: That I have knowledge of the facts, statements, and matters herein contained and the log of the above-described well as filed and that the same are true and correct. So help me God.

(Signature) Leo F. Dreiling
Leo F. Dreiling, Route 2, Victoria, Kansas
(Address)

SUBSCRIBED AND SWORN TO before me this 16th day of February, 1967

My Commission expires September 19, 1970

Joseph A. Hess
JOSEPH A. HESS Notary Public.

15-051-20027-00-00

L. J. DREILING and SONS, Inc.

VICTORIA, KANSAS

WELL LOG

Company	D & D Drilling Company, Inc. 307 Schweiter Bldg.	Sec. 17	Twp. 11	Rng. 20
Farm	Wichita, Kansas Denning	Location	NW SE NW	
Total Depth	3350'	County	Ellis	
Comm.	2-11-67	Elevation:	2071'	K.B.
Comp.	2-15-67		2068'	D. F.
Contractor	L. J. Dreiling & Sons, Inc. Route 2 Victoria, Kansas 67671		2066'	G. R.
	Casing Record	Cement Record	Production: D & A	
	181' 8 5/8"	165 sacks cement		

Figures Indicate Bottom of Formations

0'	40'	Post Rock
40'	180'	Clay & Shale
180'	945'	Shale & Sand
945'	995'	Shale
995'	1200'	Sand
1200'	1506'	Red Bed
1506'	1512'	Anhy.
1512'	1554'	Anhy.
1554'	1959'	Shale & Shells
1959'	2273'	Shale & Lime
2273'	2520'	Shale & Lime
2520'	2710'	Shale & Lime
2710'	2950'	Lime & Shale
2950'	3167'	Shale & Lime
3167'	3172'	Shale & Lime
3172'	3280'	Lime & Shale
3280'	3350'	Lime & Shale
3350'	T.D.	

STATE OF KANSAS)
(ss
COUNTY OF ELLIS)

I, Leo F. Dreiling, of the L. J. Dreiling & Sons, Inc., upon oath states that the above and foregoing is a true and correct copy from the Daily Drilling Report from your Denning #1.

Leo F. Dreiling
LEO F. DREILING

Subscribed and sworn to before me this 16th day of February 1967.

Joseph A. Hess
JOSEPH A. HESS NOTARY PUBLIC

My commission expires: September 19, 1970