


Give All Information Completely
Make Required Affidavit
Mail or Deliver Report to:
Conservation Division
State Corporation Commission
211 No. Broadway
Wichita, Kansas

WELL PLUGGING RECORD

ELLIS County, Sec. 17 Twp. 11s Rge. (X) 20 (W)

Location as "NE/CNW/SW" or footage from lines C NW NE
Lease Owner PETROLEUM, INC.,
Lease Name DENNING "D" Well No. 1
Office Address ROUTE #2, GREAT BEND, KANSAS
Character of Well (completed as Oil, Gas or Dry Hole) DRY HOLE
Date well completed JANUARY 12, 19 65
Application for plugging filed JANUARY 12, 19 65
Application for plugging approved JANUARY 12, 19 65
Plugging commenced JANUARY 12, 19 65
Plugging completed JANUARY 13, 19 65
Reason for abandonment of well or producing formation NO PRODUCEABLE ZONES

NORTH

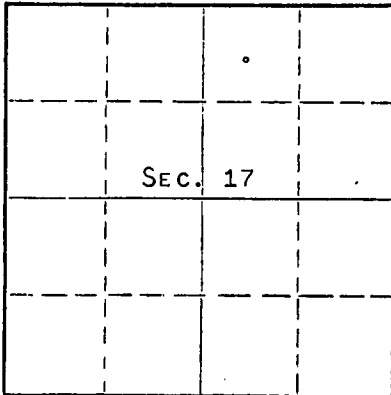

Locate well correctly on above
Section Plat

If a producing well is abandoned, date of last production - 19
Was permission obtained from the Conservation Division or its agents before plugging was commenced? YES

Name of Conservation Agent who supervised plugging of this well ELDON PETTY, BOX 326, HAYS, KANSAS
Producing formation _____ Depth to top _____ Bottom _____ Total Depth of Well 3383 Feet
Show depth and thickness of all water, oil and gas formations.

OIL, GAS OR WATER RECORDS

CASING RECORD

FORMATION	CONTENT	FROM	TO	SIZE	PUT IN	PULLED OUT
				8-5/8"	219	NONE

Describe in detail the manner in which the well was plugged, indicating where the mud fluid was placed and the method or methods used in introducing it into the hole. If cement or other plugs were used, state the character of same and depth placed, from _____ feet to _____ feet for each plug set.

MUDDED UP WITH HEAVY MUD THROUGH DRILL PIPE TO 540', FOLLOWED BY A WOODEN PLUG AND 20 SACKS CEMENT. MUDDED UP WITH HEAVY MUD TO 210', FOLLOWED BY A WOODEN PLUG AND 20 SACKS CEMENT. MUDDED UP WITH HEAVY MUD TO 35', FOLLOWED BY A WOODEN PLUG, 1/2 SACKS HULLS AND 10 SACKS CEMENT TO BASE OF WELL CELLAR.

RECEIVED
STATE CORPORATION COMMISSION

JAN 28 1965

1-28-1965

CONSERVATION DIVISION
Wichita, Kansas

(If additional description is necessary, use BACK of this sheet)

Name of Plugging Contractor GARVEY DRILLING COMPANY
Address ROUTE #2, GREAT BEND, KANSAS

STATE OF KANSAS, COUNTY OF BARTON, ss.
MONTE CHADD (employee of owner) or (owner or operator) of the above-described

well, being first duly sworn on oath, says: That I have knowledge of the facts, statements, and matters herein contained and the log of the above-described well as filed and that the same are true and correct. So help me God. MONTE CHADD, DIST. PROD. SUPT.

(Signature) *Monte Chadd*

ROUTE #2, GREAT BEND, KANSAS
(Address)

SUBSCRIBED AND SWORN TO before me this 26 day of JANUARY, 19 65

My commission expires OCTOBER 19, 1968 Notary Public.

WELL LOG

COMPANY Petroleum, Inc. 15-051-30015-00-00 SEC. 17 T. 11S R. 20W


FARM Denning NO. D-1 LOC. NW NE

TOTAL DEPTH 3383' COUNTY Ellis

COMM. 1-7-65 COMP. 1-13-65

CONTRACTOR Garvey Drilling Company

CASING 8 5/8" @ 219' w/200 sx

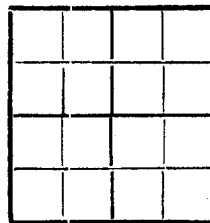

ELEVATION

PRODUCTION D & A

FIGURES INDICATE BOTTOM OF FORMATIONS

40' Post Rock
220' Shale and Sand
640' Shale
750' Sand Streaks
1100' Shale and Sand Streaks
1200' Sand
1505' Shale and Shells
1545' Anhydrite
1550' Shale
1920' Shale and Shells
2110' Shale
2330' Lime and Shale
2455' Lime
3225' Lime and Shale
3383' Lime
3383' RTD

RECEIVED
STATE CORPORATION COMMISSION
1-28-1965
JAN 28 1965

CONSERVATION DIVISION
Wichita, Kansas

State of Kansas }
County of Barton } SS

I, Sam N. Stephens of Garvey Drilling Company

upon oath state the above and foregoing is a true and correct copy of the log of the Denning D-1 well.

Sam N. Stephens

Subscribed and sworn to before me this 25th day of January 1965

My Commission Expires: October 19th, 1968

Paul S. Freeman
NOTARY PUBLIC