

WELL PLUGGING RECORD

STATE OF KANSAS STATE CORPORATION COMMISSION


Give All Information Completely Make Required Affidavit Mail or Deliver Report to: Conservation Division State Corporation Commission 800 Biting Building Wichita, Kansas

FORMATION PLUGGING RECORD

Strike out upper line when reporting plugging off formations.

Trego County. Sec. 26 Twp. 11 Rge. 23 (E) (W) Location as "NE 1/4 NW 1/4 SW 1/4" or footage from lines. NW 1/4 NE NW Lease Owner. Lauck & Moncrief et.al. Lease Name. Howat Well No. 1 Office Address. 520 Fourth Nat'l Bank Bldg. Wichita, Kans Character of Well (completed as Oil, Gas or Dry Hole) dry hole Date well completed July 18th 19 45 Application for plugging filed July 20 19 45 Application for plugging approved July 20 19 45 Plugging commenced Aug. 11 19 45 Plugging completed Aug. 22 19 45 Reason for abandonment of well or producing formation dry hole

NORTH

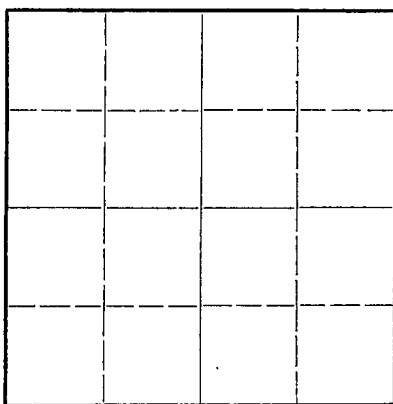

Locate well correctly on above Section Plat

If a producing well is abandoned, date of last production 19. Was permission obtained from the Conservation Division or its agents before plugging was commenced? yes

Name of Conservation Agent who supervised plugging of this well Kerr Producing formation none Depth to top Bottom Total Depth of Well 4152 Feet

Show depth and thickness of all water, oil and gas formations.

OIL, GAS OR WATER RECORDS

CASING RECORD

Table with 7 columns: Formation, Content, From, To, Size, Put In, Pulled Out. Row 1: Arbuckle, water, 4144, 4152, 10", 157, none. Row 2: 5", 4086, 889'


Describe in detail the manner in which the well was plugged, indicating where the mud fluid was placed and the method or methods used in introducing it into the hold. If cement or other plugs were used, state the character of same and depth placed, from feet to feet for each plug set.

Perforated 4053-67 3737-42

Mud 4152-4086 cement 4086-4074

Lane Wells Plug 3778 mud 3778 - 3730 cement 3730 - 3695 mud 3695 - 150' cement 150 - 125' mud 125 - 15' cement 15 - 6'

PLUGGING FILE SEC. 26-11-R-23W BOOK PAGE 20 LINE 31

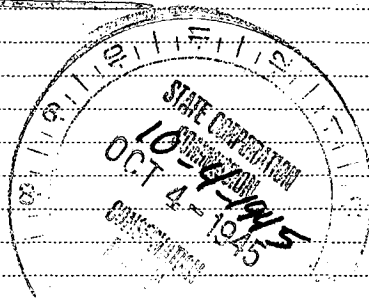

(If additional description is necessary, use BACK of this sheet)

Correspondence regarding this well should be addressed to Lauck & Moncrief Address 520 Fourth Nat'l Bank Building Wichita, Kans

STATE OF Kansas, COUNTY OF Sedgewick, ss. E. C. Moncrief (owner or operator) of the above-described well, being first duly sworn on oath, says: That I have knowledge of the facts, statements, and matters herein contained and the log of the above-described well as filed and that the same are true and correct. So help me God.

(Signature) E. C. Moncrief 520 Fourth Nat'l Bank Bldg. Wichita, Kans (Address)

SUBSCRIBED AND SWORN to before me this 3 day of October, 19 45

Elizabeth Gay Notary Public

My commission expires Sept. 14, 1947

15-195-01336-00-00

LAUCK & MONGRIET

Howat No.1
NWc NE NW

Sec. 26 T 11S R23W
Trego County Kansas

Commenced June 16, 1945
Completed July 18, 1945

Casing:

10" 157' cemented 130 sacks
5" 4086' cemented

Surface	30
sand	35
shale & shells	775
sand	800
shale & shells	870
lime	960
shale, shells, sand	1250
shale	1307
sand	1600
lime	1690
shale	2415
shale & lime	2697
shale & shells	2730
lime	2822
shale & lime	2835
lime	2883
shale & lime	2916
lime	3035
shale & lime	3232
lime	3340
shale & lime	3385
lime	3695
lime & chert	3715
lime	3882
shale	3905
shale & lime	3968
shale	3990
shale & chert	4000
shale & lime	4045
conglomerate	4133
Arbuckle lime	4141

Tops corrected

Derrick floor

Neva	2922
Topeka	3397
Lansing	3637
show oil	3738-41
show oil	3749-56
show oil	4053-4065
Conglomerate	4087
Arbuckle	4144

Total Depth 4152

Plug 4074
perforate 4053-67 58 shots
show oil;

Acidized 1000 gallons
10 gallons oil per hr.

plug 3778
perforate 3737-42 28 shots
show oil

acidized 3749-57 24 shots
1000 gallons
water trace of oil

Dry and abandoned.

7-20-1945

Above measurements uncorrected
correct down 12 ft. from 2250 ft.

26 11 23W
20 31