


15-195-20318-00-00

FORM CP-4

STATE OF KANSAS
STATE CORPORATION COMMISSION
CONSERVATION DIVISION
P. O. BOX 17027
WICHITA, KANSAS 67217

WELL PLUGGING RECORD

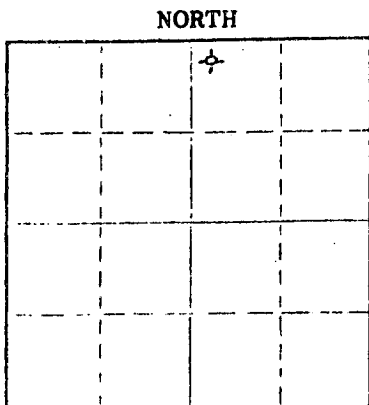

Locate well correctly on above Section Plat

Trego County, Sec 30 Twp 11S Rge 23 (W)
Location as "NE/CNWKSWK" or footage from lines. NW NW NE
Lease Owner Mack Oil Co.
Lease Name Frank Rhoades Well No. 1
Office Address 812 Union Center Bldg., Wichita, KS 67202
Character of Well (completed as Oil, Gas or Dry Hole) Dry hole
Date well completed 4-29-75 19
Application for plugging filed 4-29-75 19
Application for plugging approved 4-29-75 19
Plugging commenced 4-29-75 19
Plugging completed 4-29-75 19
Reason for abandonment of well or producing formation commercial quantities of oil not found.
If a producing well is abandoned, date of last production 19
Was permission obtained from the Conservation Division or its agents before plugging was commenced? yes

Name of Conservation Agent who supervised plugging of this well Leo Massey-Hays, KS
Producing formation _____ Depth to top _____ Bottom _____ Total Depth of Well 4057 Feet
Show depth and thickness of all water, oil and gas formations.

OIL, GAS OR WATER RECORDS

CASING RECORD

FORMATION	CONTENT	FROM	TO	SIZE	PUT IN	PULLED OUT
				8-5/8"	223'	

Describe in detail the manner in which the well was plugged, indicating where the mud fluid was placed and the method or methods used in introducing it into the hole. If cement or other plugs were used, state the character of same and depth placed, from _____ feet to _____ feet for each plug set.

1st plug @ 900' w/70 sx
2nd plug @ 215' w/20 sx
3rd plug @ 40' w/bridge and 10 sx.

(If additional description is necessary, use BACK of this sheet)
Name of Plugging Contractor Rains & Williamson Oil Co., Inc.
Address 435 Page Court, 220 W. Douglas, Wichita, KS 67202

STATE OF Kansas COUNTY OF Sedgwick, ss.
Wilson Rains, President (employee of owner) or (owner or operator) of the above-described well, being first duly sworn on oath, says: That I have knowledge of the facts, statements, and matters herein contained and the log of the above-described well as filed and that the same are true and correct. So help me God.

(Signature) Wilson Rains Wilson Rains
435 Page Court, 220 W. Douglas, Wichita, KS
(Address) 67202

My commission expires October 4, 1975
1st day of May, 1975
Juanita M. Green Notary Public.



RECEIVED
STATE CORPORATION COMMISSION
5-8-1975
CONSERVATION DIVISION
Wichita, Kansas

15-195-20318-00-00
WELL LOG

COMPANY Mack Oil Co.

SEC. 30 T. 11S R. 23W

FARM Frank Rhoades NO. 1

LOC. NW NW NE


RIG. NO. 7

TOTAL DEPTH 4057

COMM. 4-21-75

COMP. 4-29-75

COUNTY Trego KANSAS

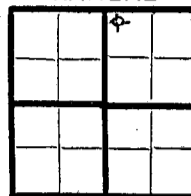

CONTRACTOR Rains & Williamson Oil Co., Inc.

CASINO

20 10
15 8-5/8" @ 223' w/150 sx common, 2% gel
12 6
13 5

ELEVATION 2405 KB

3% cc

PRODUCTION D&A

FIGURES INDICATE BOTTOM OF FORMATIONS

Top Hole Soil	40
Shale	220
Sand & Shale	920
Sand	1170
Shale	1500
Sand	1710
Shale	1980
Anhydrite	2017
Shale	2235
Shale & Lime	3768
Lime	4057
<u>Rotary Total Depth</u>	<u>4057</u>

RECEIVED
STATE CORPORATION COMMISSION
5-8-1975

CONSERVATION DIVISION
Wichita, Kansas

State of Kansas

County of Sedgwick

I, Wilson Rains, President of the Rains & Williamson Oil Company, Inc.

upon oath state that the above and foregoing is a true and correct copy of the log of the #1 Frank Rhoades well.

Wilson Rains
Wilson Rains



Subscribed and sworn to before me this 1st day of May 1975

My Commission Expires: October 4, 1975

Juanita M. Green
NOTARY PUBLIC
Juanita M. Green