


WELL PLUGGING RECORD

Give All Information Completely  
Make Required Affidavit  
Mail or Deliver Report to:  
Conservation Division  
State Corporation Commission  
800 Bittling Building  
Wichita, Kansas

Trego County, Sec. 7 Twp. 11S Rge. 22W (XX XXXX)

NORTH

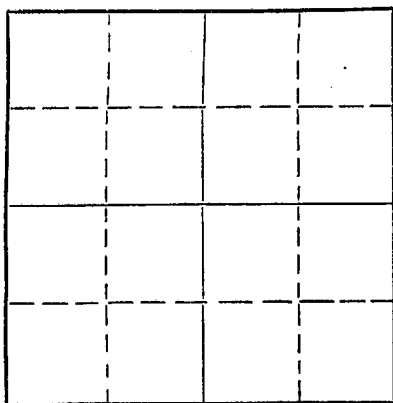

Locate well correctly on above  
Section Plat

Location as "NE/CNW&SW" or footage from lines SE SE SE  
Lease Owner Davis Bros. & Prime Drilling Company  
Lease Name Buckholz Well No. 1  
Office Address 1005 Central Bldg., Wichita, Kansas  
Character of Well (completed as Oil, Gas or Dry Hole) Dry Hole  
Date well completed 12-20-53 19  
Application for plugging filed 1-7-54 19  
Application for plugging approved 19  
Plugging commenced 12-30-53 19  
Plugging completed 12-30-53 19  
Reason for abandonment of well or producing formation Dry Hole

If a producing well is abandoned, date of last production 19  
Was permission obtained from the Conservation Division or its agents before plugging was commenced? Yes

Name of Conservation Agent who supervised plugging of this well M. A. Rives  
Producing formation None Depth to top XX Bottom XX Total Depth of Well 3920 Feet  
Show depth and thickness of all water, oil and gas formations.

OIL, GAS OR WATER RECORDS

CASING RECORD

FORMATION	CONTENT	FROM	TO	SIZE	PUT IN	PULLED OUT

Describe in detail the manner in which the well was plugged, indicating where the mud fluid was placed and the method or methods used in introducing it into the hole. If cement or other plugs were used, state the character of same and depth placed, from \_\_\_\_\_ feet to \_\_\_\_\_ feet for each plug set.

Filled hole from bottom to 190' with heavy drilling mud; set plug at 190' with 20 sax of cement; filled hole with extra heavy drilling mud to 40' set plug at 40' and cemented with 10 sax of cement.

1-15-1954

(If additional description is necessary, use BACK of this sheet)

Name of Plugging Contractor Prime Drilling Company  
Address 1005 Central Bldg., Wichita, Kansas


STATE OF Kansas, COUNTY OF Sedgwick, ss.  
Prime Drilling Company (employee of owner) or (owner or operator) of the above-described well, being first duly sworn on oath, says: That I have knowledge of the facts, statements, and matters herein contained and the log of the above-described well as filed and that the same are true and correct. So help me God.

(Signature) [Signature] Secretary-Treas.  
1005 Central Bldg., Wichita, Kansas  
(Address)

SUBSCRIBED AND SWORN to before me this 7th day of January, 19 54.

My commission expires 10-11-57

[Signature] Notary Public.

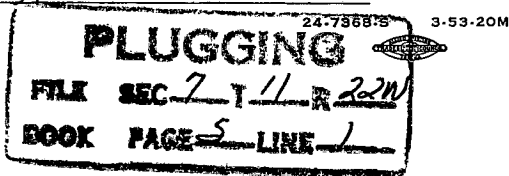

15-195-00257-00-00

ROTARY DRILLING LOG

OPERATOR: PRIME DRILLING COMPANY  
Buckholz #1  
S. 34 SE Sec. 7-11S-22W  
Trego County, Kansas

CONTRACTOR: PRIME DRILLING COMPANY  
COLM: 12-14-53  
COLP: 12-30-53

FORMATION

Sand & Shale	40
Shale	135
Shale & Shells	203
Shale & Sand	600
Shale	720
Sand	790
Sand, Shale & Shells	880
Sand & Shale	995
Sand	1340
Shale & Shells-	1610
Shale & Lime	2160
Lime	3416
Lime & Shale	3470
Lime	3495
Lime & Shale	3740
Lime, Chert & Shale	3795
Total Depth	3920

REMARKS

Run 8 jts. of 8-5/8" Surface Set @ 203'  
cemented with 125 sax & 2% cc.

We certify that the above log is true  
and correct to the best of our knowledge  
and belief.

PRIME DRILLING COMPANY

By R. R. Mc Nicol

