

Notice: Fill out COMPLETELY and return to Conservation Division at the address below within 60 days from plugging date.

KANSAS CORPORATION COMMISSION
OIL & GAS CONSERVATION DIVISION
WELL PLUGGING RECORD
K.A.R. 82-3-117

Form CP-4
December 2003
Type or Print on this Form
Form must be Signed
All blanks must be Filled

Lease Operator: Pickrell Drilling Company, Inc.
Address: 100 S Main, Suite 505, Wichita, KS 67202
Phone: (316) 262-8427 Operator License #: 5123
Type of Well: SWD Docket #: D-26615
(Oil, Gas D&A, SWD, ENHR, Water Supply Well, Cathodic, Other) (If SWD or ENHR)
The plugging proposal was approved on: _____ (Date)
by: Steve Durrant (KCC District Agent's Name)
Is ACO-1 filed? Yes No If not, is well log attached? Yes No
Producing Formation(s): List All (If needed attach another sheet)

Depth to Top: _____ Bottom: _____ T.D. _____

Depth to Top: _____ Bottom: _____ T.D. _____

Depth to Top: _____ Bottom: _____ T.D. _____

API Number: 15 - 083-21347-0001
Lease Name: King
Well Number: 1
Spot Location (QQQQ): 150'S - C - N/2 - NW
4470 4518 Feet from North / South Section Line
4620 4002 Feet from East / West Section Line
Sec. 7 Twp. 21 S. R. 24 East West
County: Hodgeman
Date Well Completed: _____
Plugging Commenced: 3-10-09
Plugging Completed: 3-10-09

KCC
PMT
per
GPS
P105

Show depth and thickness of all water, oil and gas formations.

Oil, Gas or Water Records		Casing Record (Surface Conductor & Production)				
Formation	Content	From	To	Size	Put In	Pulled Out
				8 5/8	253	
				4 1/2	4409	0

Describe in detail the manner in which the well is plugged, indicating where the mud fluid was placed and the method or methods used in introducing it into the hole. If cement or other plugs were used, state the character of same depth placed from (bottom), to (top) for each plug set.

Ran 49 joints of tubing, pumped 100 sacks, circulated cement to surface, pumped 10 sacks down backside, pulled tubing, topped off with 20 sacks, welded 2 collar in 8 5/8" inc, torch casing subs out, filled cellar in.

RECEIVED
KANSAS CORPORATION COMMISSION

MAR 25 2009

CONSERVATION DIVISION
WICHITA, KS

Name of Plugging Contractor: Quality Well Service, Inc. License #: 31925
Address: 190 US Highway 56, Ellinwood, KS 67526
Name of Party Responsible for Plugging Fees: Pickrell Drilling Company, Inc.
State of Kansas County, Sedgwick, ss.

Jack Gurley (Employee of Operator) or (Operator) on above-described well, being first duly sworn on oath, says: That I have knowledge of the facts statements, and matters herein contained, and the log of the above-described well is as filed, and the same are true and correct, so help me God.

(Signature) _____

(Address) 100 S. Main, Suite 505 Wichita, KS 67202


SUBSCRIBED and SWORN TO before me this 24th day of March, 20 09
Karen A. Mans McGee My Commission Expires: 6-23-12
Notary Public



PMT

Oil Company _____ Well No. 1 SWW Field: Val Lease King
Company Man _____ Date Drilled 11/90 County Hodgeman State Kansas

150' S of C N/2 NW Sec 7-215-24W
API # 15-083-21347-0001
Docket N° D-26615

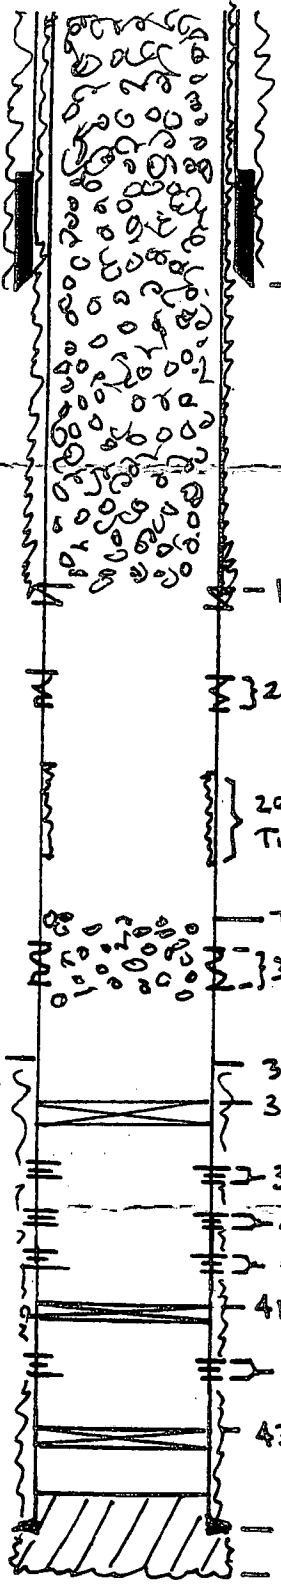

253' Base 8 5/8 w/160 Sx 60/40 Poz

1510 DV Tool w/350 Sx bits (live)

2041-2073 Hole (Saz'd)

2950-3200
Tight Casing

Top of Saz. Cmt. 3500' (Not drilled out)

3564-3597 Hole (Saz'd)

3760 T.O.C.
3850 CIBP w/saz cut on top

3910-3918
4008-4012
4081-4086
KC Perfs

4165 CIBP

4198-4202 Marm Perfs

4380 CIBP

4409 Base 4 1/2 10.5# w/150 Sx ASC
4417 RTD

3-10-2009

P&A well. Ran 2 3/8" to 1500', circ 100 Sx cut to surface, P.O.H., top off w/15 Sx. Pump 15 Sx into annulus at 300#. Hold.

Final Report
After P&A

RECEIVED
KANSAS CORPORATION COMMISSION
MAR 25 2009
CONSERVATION DIVISION
WICHITA, KS