


WELL PLUGGING RECORD

Give All Information Completely
Make Required Affidavit
Mail or Deliver Report to:
Conservation Division
State Corporation Commission
211 No. Broadway
Wichita, Kansas

NORTH

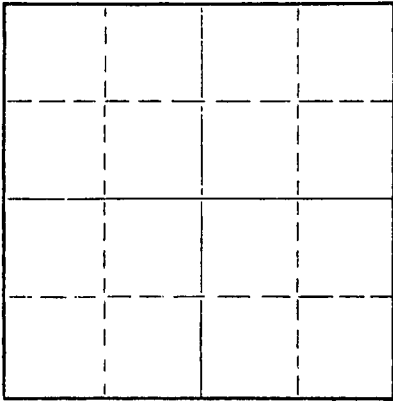

Locate well correctly on above
Section Plat

Trego County, Sec. 13 Twp. 11 Rge. 24 (E) W (W)
Location as "NE/CNW&SW&" or footage from lines SW NW NE
Lease Owner Leo J. Dreiling Oil Company
Lease Name Walker "B" Well No. #1
Office Address Route 2, Victoria, Kansas
Character of Well (completed as Oil, Gas or Dry Hole) D & A
Date well completed 12-18 19 66
Application for plugging filed 12-18 19 66
Application for plugging approved 12-18 19 66
Plugging commenced 12-18 19 66
Plugging completed 12-18 19 66
Reason for abandonment of well or producing formation Dry

If a producing well is abandoned, date of last production 19
Was permission obtained from the Conservation Division or its agents before plugging was commenced? Yes

Name of Conservation Agent who supervised plugging of this well Bill Nichols
Producing formation _____ Depth to top _____ Bottom _____ Total Depth of Well _____ Feet
Show depth and thickness of all water, oil and gas formations.

OIL, GAS OR WATER RECORDS

CASING RECORD

FORMATION	CONTENT	FROM	TD	SIZE	PUT IN	PULLED OUT
SURFACE PIPE				8 5/8"	168'	

Describe in detail the manner in which the well was plugged, indicating where the mud fluid was placed and the method or methods used in introducing it into the hole. If cement or other plugs were used, state the character of same and depth placed, from _____ feet to _____ feet for each plug set.

Filled rotary hole to a depth of 600' where 1st. plug was set using 25 sacks cement.
Filling hole with rotary mud to a depth of 180' where 2nd plug was set using 25 sks. cement.
Rotary mud was used to fill hole to a depth of 40' where 3rd. plug was set using 10 sks. cement and filling hole to surface.

RECEIVED
12-20-1966
DEC 20 1966
CONSERVATION DIVISION
Wichita, Kansas

(If additional description is necessary, use BACK of this sheet)

Name of Plugging Contractor L. J. Dreiling & Sons, Inc.
Address Route 2, Victoria, Kansas

STATE OF KANSAS, COUNTY OF ELLIS, ss.
I, Leo F. Dreiling (employee of owner) or (owner or operator) of the above-described well, being first duly sworn on oath, says: That I have knowledge of the facts, statements, and matters herein contained and the log of the above-described well as filed and that the same are true and correct. So help me God.

(Signature) Leo F. Dreiling
Leo F. Dreiling Victoria, Kansas
(Address)

SUBSCRIBED AND SWORN TO before me this 19th day of December, 19 66

My commission expires September 19, 1970

Joseph A. Hess
Joseph A. Hess Notary Public.

15-195-30167-00-00

L. J. DREILING and SONS, Inc.

VICTORIA, KANSAS

WELL LOG

Company Leo J. Dreiling Oil Company
Victoria, Kansas

Sec. 13 Twp. 11 Rng. 24

Farm Walker "B" No. #1

Location SW NW NE

Total Depth 3970'

County Trego

Comm. 12-12-66 Comp. 12-18-66

2361' K.B.

Elevation: 2358' D. F.

Contractor L. J. Dreiling & Sons, Inc.
Victoria, Kansas

2356' G. R.

Casing Record
168' 8 5/8"

Cement Record
125 sack cement

Production:
D & A

Figures Indicate Bottom of Formations

0'	40'	Sand
40'	168'	Shale
168'	589'	Shale
589'	982'	Shale
982'	1010'	Hard Sand w/shale Streaks
1010'	1115'	Shale w/sand Streaks
1115'	1148'	Shale
1148'	1557'	Sand
1557'	1947'	Shale & Redbed
1947'	1992'	Anhy.
1992'	2030'	Shale & Shells
2030'	2370'	Shale & Shells
2370'	2459'	Shale & Lime
2459'	2710'	Shale & Lime
2710'	2915'	Lime & Shale
2915'	3114'	Lime & Shale
3114'	3240'	Lime & Shale
3240'	3420'	Lime & Shale
3420'	3622'	Lime & Shale
3622'	3726'	Lime & Shale
3726'	3840'	Lime & Shale
3840'	3870'	Lime
3870'	3897'	Lime
3897'	3940'	Lime
3940'	3970'	Lime
3970'	T.D.	

STATE OF KANSAS)
)ss
COUNTY OF ELLIS)

I, Leo F. Dreiling, of the L. J. Dreiling & Sons, upon oath states that the above and foregoing is a true and correct copy from the Daily Drilling Report from your Walker "B" #1.

Leo F. Dreiling
LEO F. DREILING

Subscribed and sworn to before me this 19th day of December 1966.

Joseph A. Hess
Joseph A. Hess, Notary Public

My commission expires: September 19, 1970