


STATE OF KANSAS
STATE CORPORATION COMMISSION

Form CP-4

WELL PLUGGING RECORD

Give All Information Completely
Make Required Affidavit
Mail or Deliver Report to:
Conservation Division
State Corporation Commission
P. O. Box 17027
Wichita, Kansas 67217
NORTH

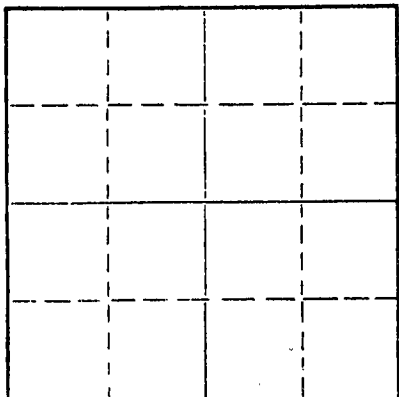

Locate well correctly on above
Section Plat

Trego County, Sec 13 Twp. 11 Rge. 24 (E) W (W)
Location as "NE/CNWxSWx" or footage from lines SW NE NW
Lease Owner Dreiling Oil, Inc.
Lease Name Littlechild Well No. 2
Office Address Rt. #2, Victoria, Kansas 67671
Character of Well (completed as Oil, Gas or Dry Hole)
Date well completed 12-11- 19 66
Application for plugging filed 5-21 19 72
Application for plugging approved 5-23 19 72
Plugging commenced 6-7 19 72
Plugging completed 6-7 19 72
Reason for abandonment of well or producing formation

If a producing well is abandoned, date of last production April 30 19 72
Was permission obtained from the Conservation Division or its agents before plugging was commenced? yes

Name of Conservation Agent who supervised plugging of this well Bill Nichols, Morland, Kansas
Producing formation Depth to top Bottom Total Depth of Well 3,920' Feet
Show depth and thickness of all water, oil and gas formations.

OIL, GAS OR WATER RECORDS

CASING RECORD

FORMATION	CONTENT	FROM	TO	SIZE	PUT IN	PULLED OUT
Surface Pipe				8 5/8"	163'	none
Casing				4 1/2"	3920'	1850'

Describe in detail the manner in which the well was plugged, indicating where the mud fluid was placed and the method or methods used in introducing it into the hole. If cement or other plugs were used, state the character of same and depth placed, from feet to feet for each plug set.

Plugged with 5 sacks Hulls, 25 Gel. 150 cu ft. cement. 250# Max. Pressure.
75# Shut In.

RECEIVED
STATE CORPORATION COMMISSION
6-9-1972
JUN 9 1972
CONSERVATION DIVISION
Wichita, Kansas

(If additional description is necessary, use BACK of this sheet)
Name of Plugging Contractor Dreiling Oil, Inc.
Address Victoria, Kansas 67671


STATE OF KANSAS, COUNTY OF ELLIS, ss.
I, Joe Hess, Sec. Treas. of Drlg. Contr. (employer of owner) or (owner or operator) of the above-described well, being first duly sworn on oath, says: That I have knowledge of the facts, statements, and matters herein contained and the log of the above-described well as filed and that the same are true and correct. So help me God.

(Signature) [Signature]

JOE HESS, RT. #2, Victoria, Kansas 67671
(Address)

SUBSCRIBED AND SWORN TO before me this 8th day of June, 19 72

[Signature] PATTY ROHR
PATTY ROHR
Notary Public.

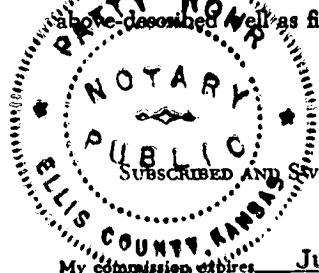

15-195-30166-00-00

L. J. DREILING and SONS, Inc.

VICTORIA, KANSAS

WELL LOG

Company Leo J. Dreiling Oil Co.
Victoria, Kansas

Sec. 13 Twp. 11 Rng. 24

Farm Littlechild No.#2

Location SW NE NW

Total Depth 3920'

County Trego

Comm. 12-5-66

Comp. 12-11-66

2332' K.B.

Elevation: 2329' B.F.

Contractor L. J. Dreiling & Sons, Inc.
Victoria, Kansas

2327' G.R.

Casing Record
163' 5 5/8"
3920' 4 1/2"

Cement Record
125 Sun Set Cement
125 Salt Cement
w/10 bbl. Salt Flush

Production:
Producing Well

RECEIVED
STATE CORPORATION COMMISSION
5-23-1972
DEC 23 1972

CONSERVATION DIVISION
Wichita, Kansas

Figures Indicate Bottom of Formations

0'	40'	Sand
40'	163'	Shale
163'	528'	Shale
528'	922'	Shale
922'	980'	Shale & Hard Sand
980'	1370'	Shale w/Sand Streaks
1370'	1440'	Shale
1440'	1640'	Sand
1640'	1929'	Shale & Red Bed
1929'	1972'	Anhy.
1972'	2010'	Shale & shells
2010'	2270'	Shale & Shells
2270'	2465'	Shale & Lime
2465'	2715'	Shale & Lime
2715'	2945'	Shale & Lime
2945'	3127'	Shale & Lime
3127'	3355'	Lime & Shale
3355'	3522'	Lime & Shale
3522'	3610'	Lime & Shale
3610'	3740'	Lime & Shale
3740'	3835'	Lime
3835'	3857'	Lime
3857'	3880'	Lime
3880'	3920'	Lime
3920'	T.D.	

STATE OF KANSAS)
)ss
COUNTY OF ELLIS)

I, Leo F. Dreiling, of the L. J. Dreiling & Sons, upon oath states that the above and foregoing is a true and correct copy from the Daily Drilling Report from your Littlechild #2.

Leo F. Dreiling
LEO F. DREILING

Subscribed and sworn to before me this 13th day of December 1966.

Joseph A. Hess
JOSEPH A. HESS, NOTARY PUBLIC

My commission expires: September 19, 1970