


15-195-30169-00-00

STATE OF KANSAS
STATE CORPORATION COMMISSION

Form CP-4

Give All Information Completely
Make Required Affidavit
Mail or Deliver Report to:
Conservation Division
State Corporation Commission
P. O. Box 17027
Wichita, Kansas 67217
NORTH

WELL PLUGGING RECORD

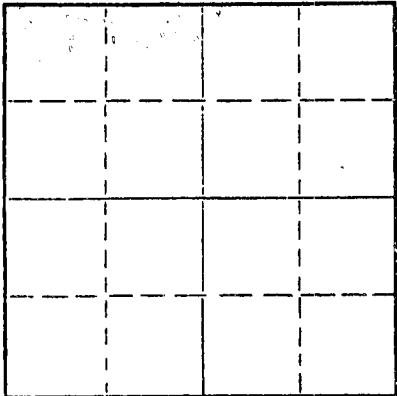

Locate well correctly on above
Section Plat

Trego County, Sec. 13 Twp. 11 Rge. 24 (E) W (W)
Location as "NE/CNW/SW" or footage from lines NE NE NW
Lease Owner Dreiling Oil, Inc.
Lease Name Littlechild Well No. 1
Office Address Rt. # 2, Victoria, Kansas 67671
Character of Well (completed as Oil, Gas or Dry Hole) _____
Date well completed 12-2- 19 66
Application for plugging filed 5-21 19 72
Application for plugging approved 5-23 19 72
Plugging commenced 6-7 19 72
Plugging completed 6-7 19 72
Reason for abandonment of well or producing formation _____

If a producing well is abandoned, date of last production April 30 1972
Was permission obtained from the Conservation Division or its agents before plugging was commenced? yes

Name of Conservation Agent who supervised plugging of this well Bill Nichols, Morland, Kansas
Producing formation _____ Depth to top _____ Bottom _____ Total Depth of Well 3,935' Feet
Show depth and thickness of all water, oil and gas formations.

OIL, GAS OR WATER RECORDS

CASING RECORD

FORMATION	CONTENT	FROM	TO	SIZE	PUT IN	PULLED OUT
Surface Pipe				8 5/8"	164'	none
Casing				4 1/2"	3935'	2500'

Describe in detail the manner in which the well was plugged, indicating where the mud fluid was placed and the method or methods used in introducing it into the hole. If cement or other plugs were used, state the character of same and depth placed, from _____ feet to _____ feet for each plug set.

Plugged with 5 sacks Hulls, 25 Gel, 150 cu ft. cement, 250# Max. Pressure, 75# Shut in.

RECEIVED
STATE CORPORATION COMMISSION
6-9-1972
JUN 9 1972

CONSERVATION DIVISION
Wichita, Kansas


(If additional description is necessary, use BACK of this sheet)

Name of Plugging Contractor Dreiling Oil, Inc.
Address Victoria, Kansas 67671

STATE OF KANSAS, COUNTY OF ELLIS, ss.
I, Joe Hess, Sec. Treas. of Drlg. Contrc. (employee of owner or owner or operator) of the above-described well, being first duly sworn on oath, says: That I have knowledge of the facts, statements, and matters herein contained and the log of the above-described well as filed and that the same are true and correct. So help me God.

(Signature) _____
JOE HESS, RT. #2, Victoria, Kansas 67671
(Address)

SUBSCRIBED AND SWORN to before me this 8th day of June, 1972

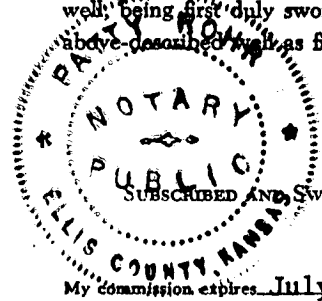

Patty Rohr
PATTY ROHR
Notary Public.

My commission expires July 20, 1975

15-195-30169-00-00

L. J. DREILING and SONS, Inc.

VICTORIA, KANSAS

WELL LOG

Company Leo J. Dreiling Oil Co.
Victoria, Kansas

Sec. 13 Twp. 11 Rng. 24

Farm Littlechild No. #1

Location NE NE NW

Total Depth 3935'

County Trego

Comm. 11-25-66

Comp. 12-2-66

Elevation: 2309' K.B.
2306' D.F.

Contractor L. J. Dreiling & Sons, Inc.
Victoria, Kansas

2304' G.R.

Casing Record
164' 8 5/8"
3935' 4 1/2"

Cement Record
125 Sunset Cement
125 Salt Cement
w/10 bbl. salt flush

Production:

Figures Indicate Bottom of Formations

0'	30'	Surface soil & Sand
30'	165'	Shale
165'	650'	Shale
650'	870'	Shale
870'	945'	Shale & Hard Sand
945'	1430'	Shale & Sand
1430'	1536'	Sand
1536'	1657'	Sand
1657'	1904'	Shale & Redbed
1904'	1954'	Anhy.
1954'	2120'	Shale & Shells
2120'	2345'	Shale & Shells
2345'	2530'	Shale & Lime
2530'	2775'	Lime & Shale
2775'	3060'	Shale & Lime
3060'	3270'	Shale & Lime
3270'	3452'	Shale & Lime
3452'	3575'	Shale & Lime
3575'	3702'	Shale & Lime
3702'	3800'	Lime
3800'	3814'	Lime
3814'	3835'	Lime
3835'	3855'	Lime
3855'	3868'	Lime
3868'	3870'	Lime
3870'	3905'	Lime
3905'	3935'	Lime
3935'	T.D.	

RECEIVED
STATE OF KANSAS
5-23-1972
COMMISSIONER OF REVENUE
NOTARY PUBLIC

STATE OF KANSAS)
)ss
COUNTY OF ELLIS)

I, Leo F. Dreiling of the L. J. Dreiling & Sons, upon oath states that the above and foregoing is a true and correct copy from the Daily Drilling Report from your Littlechild #1.

Leo F. Dreiling
LEO F. DREILING

Subscribed and sworn to before me this 7th day of December 1966.

Joseph A. Hess
JOSEPH A. HESS NOTARY PUBLIC

My commission expires: September 19, 1970