


WELL PLUGGING RECORD

Give All Information Completely
Make Required Affidavit
Mail or Deliver Report to:
Conservation Division
State Corporation Commission
212 North Market, Insurance Bldg.
Wichita, Kansas

Trego County, Sec. 14 Twp. 11 Rge. 24W (X) (W)
Location as "NE/CNW/SW" or footage from lines SW SE SW
Lease Owner Mack Oil Company
Lease Name Littlechild Well No. 2
Office Address Box 400, Duncan, Oklahoma 73533
Character of Well (completed as Oil, Gas or Dry Hole) D & A
Date well completed September 16, 1974 19
Application for plugging filed 19
Application for plugging approved 19
Plugging commenced 19
Plugging completed September 16, 1974 19
Reason for abandonment of well or producing formation

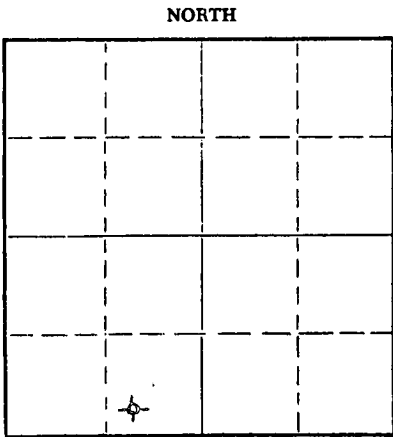

Locate well correctly on above
Section Plat

If a producing well is abandoned, date of last production 19
Was permission obtained from the Conservation Division or its agents before plugging was commenced? Yes

Name of Conservation Agent who supervised plugging of this well W. L. Nichols, Morland, Kansas
Producing formation Depth to top Bottom Total Depth of Well Feet
Show depth and thickness of all water, oil and gas formations.

OIL, GAS OR WATER RECORDS

CASING RECORD

FORMATION	CONTENT	FROM	TO	SIZE	PUT IN	PULLED OUT

Describe in detail the manner in which the well was plugged, indicating where the mud fluid was placed and the method or methods used in introducing it into the hole. If cement or other plugs were used, state the character of same and depth placed, from feet to feet for each plug set.

Plug #1 1025' 110 Cubic feet cement
Plug #2 215' 30 Cubic feet cement
Plug #3 40' 10 Cubic feet cement

Completed 7:30 P.M., September 16, 1974

W. L. Nichols, State Plugger

RECEIVED
STATE CORPORATION COMMISSION
9-30-1974
SEP 30 1974
CONSERVATION DIVISION
Wichita, Kansas

(If additional description is necessary, use BACK of this sheet)

Name of Plugging Contractor John O. Farmer, Inc.
Address Box 352, Russell, Kansas


STATE OF KANSAS, COUNTY OF RUSSELL, ss.
John O. Farmer (employee of owner) or (owner or operator) of the above-described

well, being first duly sworn on oath, says: That I have knowledge of the facts, statements, and matters herein contained and the log of the above-described well as filed and that the same are true and correct. So help me God.

(Signature) John O. Farmer
John O. Farmer, President/Contractor
Box 352, Russell, Kansas 67665
(Address)

SUBSCRIBED AND SWORN TO before me this 19th day of September, 1974

My commission expires February 15, 1975 Helen Carlson Notary Public.

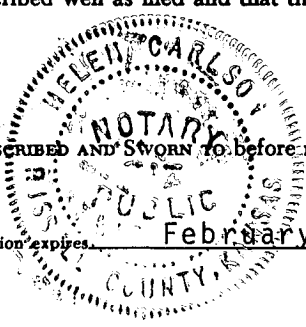

15-195-20293-00-00

DRILLERS LOG

LITTLECHILD #2

CASING RECORD:	OPERATOR:	Mack Oil Company	DESCRIPTION:
203' w/ 8-5/8" Cemented w/ 160 sx.	CONTRACTOR:	John O. Farmer, Inc.	SW SE SW Sec. 14-11S-24W Trego County, Kansas
TOTAL DEPTH:	COMMENCED:	September 7, 1974	
4060'	COMPLETED:	September 16, 1974	

<u>FORMATION</u>	<u>FROM</u>	<u>TO:</u>	<u>REMARKS</u>
Shale	203	615	
Shale & Lime	615	1165	
Shale & Shells	1165	1491	
Shale & Sand	1491	1560	
Sand	1560	1785	
Red Bed	1785	2039	
Anhydrite	2039	2080	
Shale & Shells	2080	2470	
Shale & Lime	2470	3550	
Lime	3550	3650	
Lime & Shale	3650	3760	
Lime	3760	4060	
Total Depth	4060		

RECEIVED
STATE CORPORATION COMMISSION
9-30-1974
SEP 30 1974
CONSERVATION DIVISION
Wichita, Kansas

I certify that this is a true and correct copy of the above log to the best of my knowledge.

John O. Farmer, Inc.

By John O. Farmer
John O. Farmer
President

Subscribed and sworn to before me this 19th day of September, 1974.

Helen Carlson
Helen Carlson - Notary Public

My Commission Expires:
February 15, 1975