


WELL PLUGGING RECORD

Give All Information Completely
Make Required Affidavit
Mail - Deliver Report to:
Conservation Division
State Corporation Commission
1001 No. Broadway
Wichita, Kansas

Trego County, Sec. 17 Twp 11S Rge. 24 (W)

Location as "NE/CNW/SW" or footage from lines 150' W of C NW SW
Lease Owner Gulf Oil Corporation
Lease Name Elisha Garrett Well No. 1
Office Address 316 Union Center Building, Wichita 2, Kansas
Character of Well (completed as Oil, Gas or Dry Hole) Dry hole
Date well completed 8-23 1962
Application for plugging filed orally 8-23 1962
Application for plugging approved orally 8-23 1962
Plugging commenced 8-23 1962
Plugging completed 8-23 1962
Reason for abandonment of well or producing formation Dry hole

NORTH

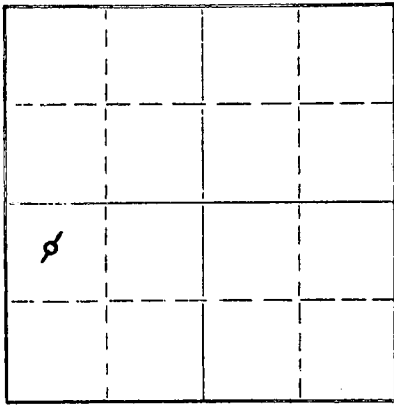

Locate well correctly on above
Section Plat

If a producing well is abandoned, date of last production None 19
Was permission obtained from the Conservation Division or its agents before plugging was commenced? Yes

Name of Conservation Agent who supervised plugging of this well Eldon Petty
Producing formation None Depth to top -- Bottom -- Total Depth of Well 4,014 Feet
Show depth and thickness of all water, oil and gas formations.

OIL, GAS OR WATER RECORDS

CASING RECORD

FORMATION	CONTENT	FROM	TO	SIZE	PUT IN	PULLED OUT
				8-5/8"OD	212'	0

Describe in detail the manner in which the well was plugged, indicating where the mud fluid was placed and the method or methods used in introducing it into the hole. If cement or other plugs were used, state the character of same and depth placed, from _____ feet to _____ feet for each plug set.

Filled with mud to 600 feet. Spotted 20 sacks of cement at 600 feet. Filled with mud to 185 feet. Spotted 20 sacks of cement at 185 feet. Filled with mud to 35 feet. Spotted 10 sacks of cement from 35 feet to surface.

RECEIVED
STATE CORPORATION COMMISSION
8-31-1962
AUG 31 1962
CONSERVATION DIVISION
Wichita, Kansas

(If additional description is necessary, use BACK of this sheet)
Name of Plugging Contractor Murfin Drilling Company
Address 617 Union Center Building, Wichita 2, Kansas

STATE OF KANSAS, COUNTY OF SEDGWICK, ss.

G. V. Kersten (employee of owner) ~~operator~~ of the above-described well, being first duly sworn on oath, says: That I have knowledge of the facts, statements, and matters herein contained and the log of the above-described well as filed and that the same are true and correct. So help me God.

(Signature) G. V. Kersten
G. V. Kersten, Area Production Manager
316 Union Center, Wichita 2, Kansas
(Address)

Subscribed and sworn to before me this 27th day of August, 1962

My commission expires June 3, 1965
C. C. Lewis Notary Public.

C. C. LEWIS, NOTARY PUBLIC

15-195-01106-00-00
WELL LOG

COMPANY **CONRO Oil Corporation**

SEC. **17** T. **11S** R. **24W**
 LOC. **0/10 SW**

FARM **ELIHA GARRETT NO. 600**

RIG. NO. **Four**

COUNTRY

Trego
KANSAS

TOTAL DEPTH **4010'**

COMM. **8/14/62**

COMP. **8/23/62**

SHOT OR TREATED **No**

CONTRACTOR **Murfin Drilling Company**

ISSUED

CASING

20 10
 15 8
 12 6
 13 5

5/8" 220' with 160 sacks

ELEVATION

PRODUCTION **Oil & Gas**

FIGURES INDICATE BOTTOM OF FORMATIONS

55' Post Rock - Sand
225' Blue Shale
920' Shale
1710' Shale & Sand
1790' Sand
2033' Red Bed
2080' Anhydrite
2590' Shale Shells
2745' Shale - Lime
3735' Lime & Shale
4010' Lime

RECEIVED
 STATE CORPORATE COMMISSION
9-24-1962
 SEP 21 1962

CONSERVATION DIVISION
 Wichita, Kansas

State of **Kansas**
 County of **Seelye** ss:

I, **Fred Murfin** of the **Murfin Drilling** Company

upon oath state that the above and foregoing is a true and correct copy of the log of the **ELIHA GARRETT #1** well.

Subscribed and sworn to before me this **14th** day of **September** 19 **62**

My Commission Expires: **June 14, 1964**

Fred Murfin

Mary Rose Blum
 NOTARY PUBLIC