

STATE OF KANSAS  
STATE CORPORATION COMMISSION

WELL PLUGGING RECORD

Give All Information Completely  
Make Required Affidavit  
Mail or Deliver Report to  
Conservation Division  
State Corporation Comm.  
245 North Water  
Wichita, KS 67202

Trego County, Sec. 22 Twp. 11S Rge. 24 E/W  
Location as "NE/CNW\SW\ " or footage from lines  
SW NW SE


Lease Owner Liberty Enterprises, Inc.  
Lease Name Struss Well No. #1  
Office Address 308 West Mill Plainville, Kansas 67663  
Character of Well (Completed as Oil, Gas or Dry Hole)  
Dry Hole

Date Well completed May 11 1980  
Application for plugging filed May 11 1980  
Application for plugging approved May 11 1980  
Plugging commenced May 11, 10:00 P.M. 1980  
Plugging completed May 11, 11:30 P.M. 1980

Reason for abandonment of well or producing formation  
No Commercial Production  
If a producing well is abandoned, date of last production  
19

Was permission obtained from the Conservation Division or  
its agents before plugging was commenced? Yes

Name of Conservation Agent who supervised plugging of this well Gil Balthazor  
Producing formation Depth to top Bottom Total Depth of Well  
Show depth and thickness of all water, oil and gas formations.

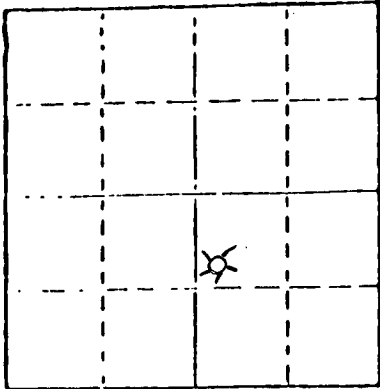

Locate well correctly on above  
Section Plat

OIL, GAS OR WATER RECORDS

CASING RECORD

FORMATION	CONTENT	FROM	TO	SIZE	PUT IN	PULLED OUT
Surface casing	common	0	221.24'	8 5/8"	221.24'	0

Describe in detail the manner in which the well was plugged, indicating where the mud fluid was placed and the method or methods used in introducing it into the hold. If cement or other plugs were used, state the character of same and depth placed, from feet to feet for each plug set.

Plug #1 @ 1020' with 70 sxs  
Plug #2 @ 210' with 20 sxs  
Plug #3 @ 40' with 10 sxs

5 sxs in rathole  
50-50 poz 6% gel  
Plugdown @ 11:30 P.M.

RECEIVED  
STATE CORPORATION COMMISSION  
5-30-1980  
MAY 30 1980

CONSERVATION DIVISION  
Wichita, Kansas

(If additional description is necessary, use BACK of this sheet)

Name of Plugging Contractor Pioneer Drilling Company, Inc.  
308 West Mill Plainville, Kansas 67663

STATE OF Kansas COUNTY OF Rooks, ss.  
Charles G. Comeau (employee of owner) or (owner or operator)  
of the above-described well, being first duly sworn on oath, says: That I have knowledge of the facts, statements, and matters herein contained and the log of the above-described well as filed and that the same are true and correct. So help me God.


(Signature)

308 West Mill Plainville, Kansas 67663  
(Address)

SUBSCRIBED AND SWORN TO before me this 29th day of May, 1980

Connie Jo Austin  
Notary Public.

My commission expires

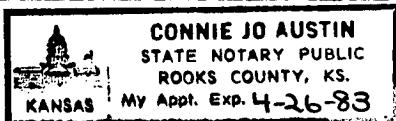

WELL LOGOPERATOR: Liberty Enterprises, Inc.WELL NAME: Struss #1 LOCATION: SW NW SE 22-11S-24WCOUNTY: Trego STATE: KansasWELL COMMENCED: May 3, 1980 WELL COMPLETED: May 11, 1980ELEVATION: 2464' K.B. TOTAL DEPTH: 4110'PRODUCTION: D & A RIG NO: #2CASING - 8-5/8": 221.24' of used 28# cemented with 130 sxs common 2% gel 3% cc  
Plugdown @ 9:15 P.M. 5 jts.  
5-1/2": noneALL MEASUREMENTS TAKEN FROM THE TOP OF ROTARY BUSHING:

FROM	TO	FORMATION	DEVIATION FROM VERTICAL	REMARKS:
0'	230'	sand and post rock	230' - 3/4 degree	
230'	828'	sand and shale		
828'	1941'	sand and shale		
1941'	2052'	red bed (shale)	2020' - 2 degrees	
2052'	2096'	Anhydrite		
2096'	2175'	shale		
2175'	2552'	sand and shale		
2552'	2731'	shale	2695' - 3/4 degree	
2731'	2930'	shale		
2930'	3120'	shale and lime		
3120'	3315'	shale and lime		
3315'	3480'	shale and lime		
3480'	3570'	shale and lime		
3570'	3672'	shale and lime	3672' - 1 3/4 degrees	
3672'	3735'	lime and shale		
3735'	3852'	lime and shale		
3852'	3931'	lime and shale		
3931'	3931'	lime		
3931'	3962'	shale and lime		
3962'	4010'	lime and shale		
4010'	4046'	shale and lime	4046' - 3/4 degree	
4046'	4084'	lime		
4084'	4110'	lime		
4110'	4110'	lime		
4110'	RTD			

RECEIVED  
STATE CORPORATIONS COMMISSION

MAY 30 1980

CONSERVATION DIVISION  
Topeka, KansasSTATE OF KANSAS  
COUNTY OFThe undersigned hereby certifies that to the best of his knowledge  
and belief, the above facts are true and correct

PIONEER DRILLING CO., INC.

By Charles BlumSUBSCRIBED AND SWORN TO, BEFORE ME, This 29<sup>th</sup> day of May, 1980.Connie Jo Austin  
NOTARY PUBLIC