

STATE OF KANSAS
STATE CORPORATION COMMISSION

15-195-00775-0000

WELL PLUGGING RECORD

Give All Information Completely
Make Required Affidavit
Mail or Deliver Report to:
Conservation Division
State Corporation Commission
212 North Market, Insurance Bldg.
Wichita, Kansas

Trego County. Sec. 21 Twp. 11 Rge. (E) 24 (W)

Location as "NE/CNW/SW" or footage from lines SW SW SE

Lease Owner Sunray Mid-Continent Oil Company

Lease Name A. L. Struss Well No. 1

Office Address P. O. Box 729, Great Bend, Kansas

Character of Well (completed as Oil, Gas or Dry Hole) Lost hole before reaching Prod.

Date well completed 8-25 19 61

Application for plugging filed 8-25 19 61

Application for plugging approved 8-25 19 61


Plugging commenced 8-25 19 61

Plugging completed 8-25 19 61

Reason for abandonment of well or producing formation Unable to recover rotary tools

If a producing well is abandoned, date of last production _____ 19 _____

Was permission obtained from the Conservation Division or its agents before plugging was commenced? Yes

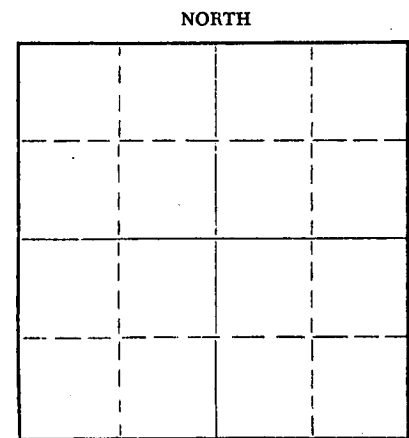

Locate well correctly on above Section Plat

Name of Conservation Agent who supervised plugging of this well Gilbert P. Leiker

Producing formation _____ Depth to top _____ Bottom _____ Total Depth of Well 3423 Feet

Show depth and thickness of all water, oil and gas formations.

OIL, GAS OR WATER RECORDS

CASING RECORD

FORMATION	CONTENT	FROM	TO	SIZE	PUT IN	PULLED OUT
				8-5/8	219	None

Describe in detail the manner in which the well was plugged, indicating where the mud fluid was placed and the method or methods used in introducing it into the hole. If cement or other plugs were used, state the character of same and depth placed, from _____ feet to _____ feet for each plug set.

Filled hole to 500' with heavy mud. Set plug and 1/4 sacks hulls at 500'.
Capped with 20 sacks cement.
Filled with heavy mud to 180'. Set plug and 1/4 sack hulls at 180'.
Capped with 20 sacks cement.
Filled to 40' with heavy mud. Set plug and 1/4 sack hulls at 40'. Filled hole to base of cellar with 10 sacks cement.
Filled with mud to surface.

NOTE: Hole lost due to inability of contractor to recover drill pipe. Rig skidded approximately 25' and redrilled. Well number remains same.

RECEIVED
STATE CORPORATION COMMISSION
10-2-1961
OCT 2 1961
CONSERVATION DIVISION
Wichita, Kansas

(If additional description is necessary, use BACK of this sheet)

Name of Plugging Contractor Garvey Drilling Company
Address Great Bend, Kansas

STATE OF Kansas, COUNTY OF Barton, ss.

J. R. Nichols (employee of owner) ~~or authorized agent~~ of the above-described well, being first duly sworn on oath, says: That I have knowledge of the facts, statements, and matters herein contained and the log of the above-described well as filed and that the same are true and correct. So help me God.

(Signature) J. R. Nichols
P.O. Box 729, Great Bend, Kansas
(Address)

SUBSCRIBED AND SWORN TO before me this 27th day of September 19 61

My commission expires December 24, 1964 Notary Public.



WELL LOG

COMPANY **SUNRAY MID-CONTINENT OIL COMPANY**

SEC. **21** T. **11S** R. **24W**

FARM **A. L. STRUSS** NO. **1**

LOC. **SW, SW, SE**


TOTAL DEPTH **3423'**

COUNTY **TREGO CO., KANSAS**

COMM. **August 17, 1961** COMP. **August 25, 1961**

CONTRACTOR **GARVEY DRILLING COMPANY**

CASING **8-5/8" @ 219' w/200 sox.**

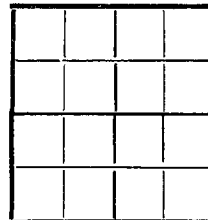

ELEVATION

PRODUCTION **LOST HOLE**

FIGURES INDICATE BOTTOM OF FORMATIONS

220	Surface soil & shale
875	Shale & shells
1090	Shale
1395	Sand
1740	Shale & sand
2092	Shale
2133	Anhydrite
2690	Shale & shells
2740	Shale
2875	Lime w/shale streaks
3020	Lime
3110	Lime & shale
3310	Shale & lime
3423	Lime & shale
3423	Lost hole. Skid rig.

RECEIVED
 STATE CORPORATION COMMISSION
 10-2-1961
 OCT 2 1961
 CONSERVATION DIVISION

State of KANSAS }
 County of BARTON } SS

I, VERNE A. MORRIS of GARVEY DRILLING COMPANY

upon oath state the above and foregoing is a true and correct copy of the log of the #1 STRUSS well.

Verne A. Morris

Subscribed and sworn to before me this 15th day of September 19 61

My Commission Expires: November 12, 1962

Brantley
 NOTARY PUBLIC