

15-167-19277-00-02

STATE OF KANSAS
STATE CORPORATION COMMISSION


WELL PLUGGING RECORD

Give All Information Completely
Make Required Affidavit
Mail or Deliver Report to:
Conservation Division
State Corporation Commission
800 Bittling Building
Wichita, Kansas

OR
FORMATION PLUGGING RECORD

Strike out upper line
when reporting plug-
ging off formations.

NORTH

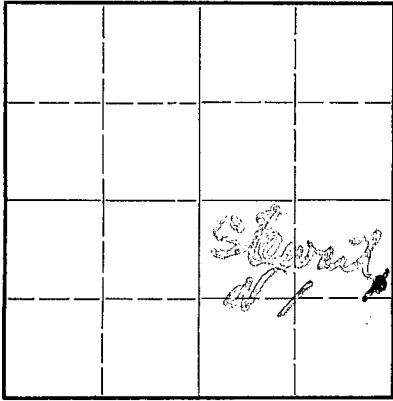

Locate well correctly on above
Section Plat

Russell County. Sec. 17 Twp. 11 Rge. 15 (E) (W)
Location as "NE 1/4 NW 1/4 SW 1/4" or footage from lines. SE/4
Lease Owner. Simon Lebow
Lease Name. Stewart Lease Well No. 1
Office Address. 807 Palace Building, Tulsa, Oklahoma
Character of Well (completed as Oil, Gas or Dry Hole) oil
Date well completed Liggett Oil Co. 19 40
Application for plugging filed. 19
Application for plugging approved. 19
Plugging commenced January 4 1946
Plugging completed. 19
Reason for abandonment of well or producing formation.
water broke in
If a producing well is abandoned, date of last production. 1942
Was permission obtained from the Conservation Division or its agents before plugging was com-
menced?

Name of Conservation Agent who supervised plugging of this well.....
Producing formation Kansas City lime Depth to top..... Bottom..... Total Depth of Well 3100 Feet
Show depth and thickness of all water, oil and gas formations.

OIL, GAS OR WATER RECORDS

CASING RECORD

Formation	Content	From	To	Size	Put In	Pulled Out

Describe in detail the manner in which the well was plugged, indicating where the mud fluid was placed and the method or methods used in introducing it into the hold. If cement or other plugs were used, state the character of same and depth placed, from..... feet to..... feet for each plug set.

This well was plugged by Liggett Oil Company but we believe it was not plugged right as the Dakota water is coming in on the Stewart #2 and we do not know where it is coming from, so we decided that the #1 Stewart was not plugged right, so I am having it plugged again as I bought htis lease a year or so ago.

(If additional description is necessary, use BACK of this sheet)

Correspondence regarding this well should be addressed to.....
Address. Simon Lebow, 807 Palace Bldg., Tulsa, Oklahoma

STATE OF Oklahoma, COUNTY OF Tulsa, ss.

..... (employee of owner) or (owner or operator) of the above-described well, being first duly sworn on oath, says: That I have knowledge of the facts, statements, and matters herein contained and the log of the above-described well as filed and that the same are true and correct. So help me God.

(Signature)

Simon Lebow

Tulsa

STATE OF OKLAHOMA
(Address)

SUBSCRIBED AND SWORN to before me this 2nd day of Jan.

JAN 3 1946
Frances R. Ellis

Frances R. Ellis

Notary Public.

01-03-1946

My commission expires July 27, 1946


now owned

15-167-19277-00 02

640 Acres
N

PLUGGING RECORD

MAIL TO CORPORATION COMMISSION
Oil and Gas Conservation Department
Oklahoma City, Oklahoma

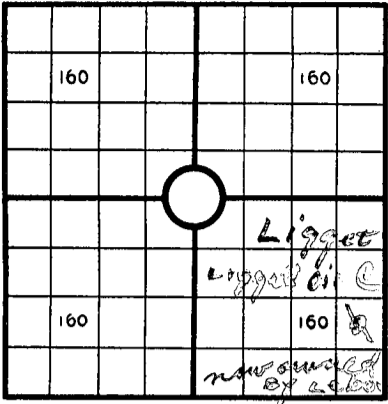

Locate Well Correctly

NOTICE: All questions on this form must be satisfactorily answered.

 Office Address Palace Bldg, Tulsa Okla
 County _____ Sec. _____ Twp. _____ Range _____
 Farm Name Stewart Well No. 1 Field _____
 Character of Well (whether oil, gas or dry) _____

Commenced Plugging _____ Finished _____ Total Depth _____

Was permission obtained from the Corporation Commission or its agents before plugging was commenced _____

Name of Conservation Officer who supervised plugging of this well _____

Name of producing sand _____ Depth top _____, Bottom _____

Show depth and thickness of all fresh water, oil and gas formations.

SAND OR ZONE RECORDS

CASING RECORDS

Formation	Content	From	To	Size	Put In	Pulled Out

Describe in detail the manner in which the well was plugged, indicating where the mud fluid was placed and the methods used in introducing it into the hole. If cement or other plugs were used, state the character of same and depth placed:

Does the above conform strictly to the oil and gas regulations? _____

The Law requires that adjacent lease, royalty and land-owners be notified; give their names with their address below:

REMARKS: Why plugged? _____ If abandoned oil or gas well, state amount and date of last production _____

Correspondence regarding this well should be addressed to _____

Address _____

I, the undersigned, being first duly sworn upon oath, state that this well record is true, correct and complete according to the records of this office and to the best of my knowledge and belief.

Name and title of representative of company

Subscribed and sworn to before me this the _____ day of _____, 194 _____

My Commission expires _____
Notary Public