


Give All Information Completely
Make Required Affidavit
Mail or Deliver Report to:
Conservation Division
State Corporation Commission
800 Bitting Building
Wichita, Kansas

WELL PLUGGING RECORD

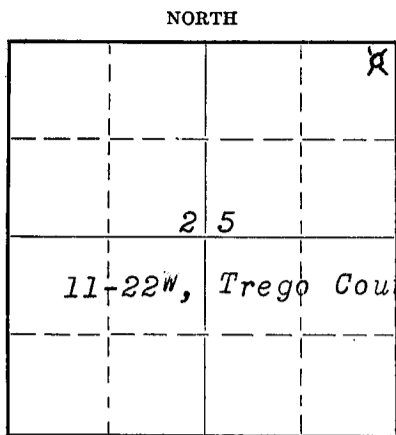

Locate well correctly on above
Section Flat

Trego County, Sec. 25 Twp. 11 Rge. 22 W (W)
Location as "NE/CNW $\frac{1}{4}$ SW $\frac{1}{4}$ " or footage from lines NE NE NE/4
Lease Owner Sahio Petroleum Company
Lease Name Butler Well No. #1
Office Address Box 671, Russell, Kansas.
Character of Well (completed as Oil, Gas or Dry Hole) Dry Hole
Date well completed 10-28 19 50
Application for plugging filed 10-30 19 50
Application for plugging approved Verbal (Eldon Petty) 10-28 19 50
Plugging commenced 10-28-50 19 50
Plugging completed 10-28 19 50
Reason for abandonment of well or producing formation Dry Hole

If a producing well is abandoned, date of last production Dry Hole 19 50
Was permission obtained from the Conservation Division or its agents before plugging was commenced? Yes

Name of Conservation Agent who supervised plugging of this well Eldon Petty
Producing formation _____ Depth to top _____ Bottom _____ Total Depth of Well 4077 Feet
Show depth and thickness of all water, oil and gas formations.

OIL, GAS OR WATER RECORDS

CASING RECORD

Formation	Content	From	To	Size	Put In	Pulled Out
<u>Soil, Sand, shale</u>		<u>0</u>	<u>100'</u>	<u>8 5/8"</u>	<u>160'</u>	<u>None</u>
<u>K.C. Lime</u>	<u>Dry</u>	<u>3628</u>	<u>3940</u>		<u>none</u>	
<u>Arbuckle Lime</u>	<u>Dry</u>	<u>4027</u>	<u>4077</u>		<u>none</u>	

Describe in detail the manner in which the well was plugged, indicating where the mud fluid was placed and the method or methods used in introducing it into the hole. If cement or other plugs were used, state the character of same and depth placed, from _____ feet to _____ feet for each plug set.

Stirred pits, filled hole with heavy mud. Placed wood plug at 155' and put 15 sacks cement on top through drill pipe (cement 155'-110'). Filled surface pipe with heavy mud to 40'. Placed wood plug at 40'. Ran 10 sacks of cement through drill pipe, filling 8 5/8" to bottom of cellar. Job Completed 6:00 P.M. 10-28-50.

(If additional description is necessary, use BACK of this sheet)

Correspondence regarding this well should be addressed to Strain Drilling Company
Address Box 188, Hays, Kansas.

11-1-1950

STATE OF Kansas. COUNTY OF Ellis. SS:

(employee of owner) or (owner or operator) of the above-described well, being first duly sworn on oath, says: That I have knowledge of the facts, statements, and matters herein contained and the log of the above-described well as filed and that the same are true and correct. So help me God.

(Signature) L. C. Strain

Box 188, Hays, Kansas.
(Address)

SUBSCRIBED AND SWORN to before me this 31st day of October, 19 50.

My commission expires March 1, 1954

LeRoy R. Power
Notary Public.

PLUGGING

Butler
39 LINE 40

WELL LOG

15-195-00220-00-00

SOHIO PETROLEUM COMPANY

Lease & well: Butler #1

NE/4 Sec. 25 Twp. 11

Elevation: 2925' Derrick floor.

Rge. 22W,
Trego County, Kansas.

Note: All measurements from rotary bushings.

- 0 5 Cellar
- 5 40 Clay & soil
- 40 65 Sand
- 65 158 Foot rock & shale
- 158 640 Shale & shells
- 640 800 Sand shale
- 800 870 Shale & shells
- 870 1270 Shale & shells
- 1270 1285 Shale & shells
- 1285 1530 Sand
- 1530 1703 Shale & shells
- 1703 1825 Anhydrite
- 1825 1860 Anhydrite
- 1860 2020 Shale & shells
- 2020 2145 Shale & shells
- 2145 2435 Shale & lime, shells
- 2435 2570 Shale & lime
- 2570 2580 Shale & lime
- 2580 2610 Lime
- 2610 2845 Shale & lime
- 2845 2775 Lime & shale
- 2775 2900 Shale & lime
- 2900 2985 Shale & lime
- 2985 3090 Shale & lime
- 3090 3205 Shale & lime
- 3205 3250 Shale & lime
- 3250 3285 Lime & shale
- 3285 3305 Lime & shale
- 3305 3430 Lime & shale
- 3430 3510 Lime & shale
- 3510 3560 Lime & shale
- 3560 3625 Lime & shale
- 3625 3660 Lime
- 3660 3723 Lime
- 3723 3770 Lime
- 3770 3820 Lime
- 3820 3865 Lime
- 3865 3920 Lime
- 3920 3940 Lime & shale
- 3940 3960 Chert & Lime
- 3960 3985 Chert & lime
- 3985 4025 Chert & lime
- 4025 4045 Lime & Chert
- 4045 4077 Lime
- 4077 (T.D.) rotary bushing meas.

COMPLETED: 10-17-50
COMPLETED: 10-28-50

CASING RECORD:

8 5/8" Surface casing set at
156' w/100 sacks cement by
Globe Cementing Co.

Ran Schlumberger Log to Total
depth.

RECEIVED
STATE CORPORATION COMMISSION
NOV - 1 1950
CONSERVATION DIVISION
Wichita, Kansas

TOBS:			
Heelner	3584	Chert & Chert	3942-4027
Lansing	3626	Arbuckle	4027
		T.D.	4077

I hereby affirm that the above and foregoing is a true and correct copy of the log of the Butler #1, located NE NE/4 Sec. 25, T-11, Rge. 22W, Trego County, Kansas.

Contractor: Strain Drilling Co.

PLUGGING
WELL SEC 25 T 11 R 22W
DATE 39 LINE 46

By *T.C. Strain*
T.C. Strain.