


WELL PLUGGING RECORD

Give All Information Completely  
Make Required Affidavit  
Mail or Deliver Report to:  
Conservation Division  
State Corporation Commission  
211 No. Broadway  
Wichita, Kansas

NORTH

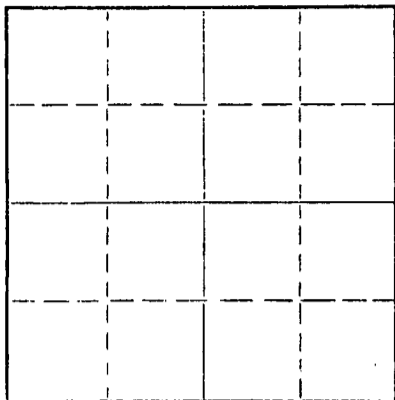

Locate well correctly on above  
Section Plat

Trego County. Sec. 27 Twp. 11S Rge. 24W (E) (W)  
Location as "NE/CNW/SW" or footage from lines SW SW SE  
Lease Owner Don E. Pratt  
Lease Name Struss Well No. 1  
Office Address Box 656, Hays, Kansas  
Character of Well (completed as Oil, Gas or Dry Hole) D & A  
Date well completed September 14 19 62  
Application for plugging filed September 14 19 62  
Application for plugging approved September 14 19 62  
Plugging commenced September 14 19 62  
Plugging completed September 14 19 62  
Reason for abandonment of well or producing formation D & A

If a producing well is abandoned, date of last production \_\_\_\_\_ 19\_\_\_\_  
Was permission obtained from the Conservation Division or its agents before plugging was commenced? Yes

Name of Conservation Agent who supervised plugging of this well Eldon Petty  
Producing formation \_\_\_\_\_ Depth to top \_\_\_\_\_ Bottom \_\_\_\_\_ Total Depth of Well 4110 Feet  
Show depth and thickness of all water, oil and gas formations.

OIL, GAS OR WATER RECORDS

CASING RECORD

FORMATION	CONTENT	FROM	TO	SIZE	PUT IN	PULLED OUT
				8 5/8"	166	-0-

Describe in detail the manner in which the well was plugged, indicating where the mud fluid was placed and the method or methods used in introducing it into the hole. If cement or other plugs were used, state the character of same and depth placed, from \_\_\_\_\_ feet to \_\_\_\_\_ feet for each plug set.

Filled hole with heavy mud.  
Plug at 550 w/20 sx cement.  
Plug at 180 w/20 sx cement.  
Plug at 40 w/10 sx cement.

**RECEIVED**  
STATE CORPORATION COMMISSION  
9-20-1962  
SEP 20 1962  
CONSERVATION DIVISION  
Wichita, Kansas

(If additional description is necessary, use BACK of this sheet)

Name of Plugging Contractor Red Tiger Drilling Company  
Address Box 173--Russell, Kansas


STATE OF KANSAS, COUNTY OF SEDGWICK, ss.  
George A. Angle (employee of owner) or (owner or operator) of the above-described well, being first duly sworn on oath, says: That I have knowledge of the facts, statements, and matters herein contained and the log of the above-described well as filed and that the same are true and correct. So help me God.

(Signature) George A. Angle  
580 Fourth Natl. Bank Bldg., Wichita, Kans.

SUBSCRIBED AND SWORN TO before me this 17th day of September, 1962

My commission expires 11-17-62

Notary Public.

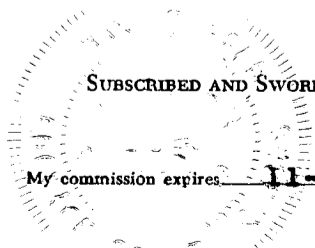

15-195-00428-00-00

DRILLERS LOG

Strass No. 1

CASING RECORD: 8 5/8" @ 100'  
w/125 sx cement

COMPANY: Don E. Pratt

CONTRACTOR: Red Tiger Drilling Co.

COMMENCED: September 7, 1962

COMPLETED: September 14, 1962

ELEVATION:

TOTAL DEPTH: 4110'

DESCRIPTION: QV DW 22  
15-112-247  
Trego Co.,  
Kansas

FORMATION	FROM	TO	REMARKS
Post Rock Shale	0	100	
Shale	100	600	
Shale & Sand	600	1800	
Shale & Red Rock	1800	2000	
Anhydrite	2000	2110	
Shale	2110	2600	
Lime & Shale	2600	3913	
Lime	3913	4110	

I certify that this is a true and correct copy of the above log to the best of my knowledge.

RED TIGER DRILLING COMPANY

*George A. Angle*  
 \_\_\_\_\_  
 George A. Angle

Subscribed and sworn to before me this 17th day of September, 1962.

*D. D. Head*  
 \_\_\_\_\_  
 Notary Public

My Commission Expires:

11-17-62

**RECEIVED**  
 STATE CORPORATION COMMISSION  
 9-20-1962  
 SEP 20 1962  
 CONSERVATION DIVISION  
 Wichita, Kansas