

WELL PLUGGING RECORD

Give All Information Completely  
Make Required Affidavit  
Mail or Deliver Report to:  
Conservation Division  
State Corporation Commission  
212 North Market, Insurance Bldg.  
Wichita, Kansas

Trego County, Sec. 24 Twp. 11S Rge. 24W (E) (W)

Location as "NE/CNW/SW" or footage from lines C NW SE

Lease Owner John O. Farmer, Inc.

Lease Name Denning Well No. #1

Office Address Box 352 Russell, Kansas 67665

Character of Well (completed as Oil, Gas or Dry Hole) Dry Hole

Date well completed 12-19-78 19

Application for plugging filed Yes 19

Application for plugging approved 19


Plugging commenced 19

Plugging completed 9:30 P.M. 12-19-78 19

Reason for abandonment of well or producing formation

If a producing well is abandoned, date of last production 19

Was permission obtained from the Conservation Division or its agents before plugging was commenced? Yes

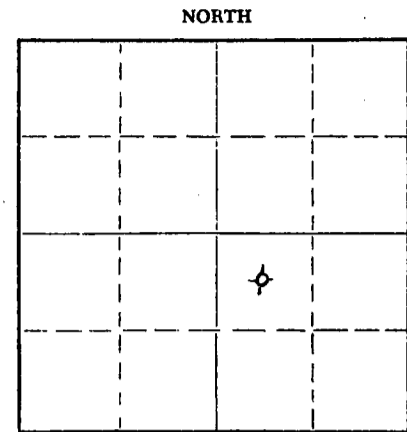

Locate well correctly on above Section Plat

Name of Conservation Agent who supervised plugging of this well Leo Massey

Producing formation Depth to top Bottom Total Depth of Well Feet

Show depth and thickness of all water, oil and gas formations.

OIL, GAS OR WATER RECORDS

CASING RECORD

FORMATION	CONTENT	FROM	TO	SIZE	PUT IN	PULLED OUT

Describe in detail the manner in which the well was plugged, indicating where the mud fluid was placed and the method or methods used in introducing it into the hole. If cement or other plugs were used, state the character of same and depth placed, from feet to feet for each plug set.

- Plug #1 900' w/ 70 sx. cement
- Plug #2 200' w/ 20 sx. cement
- Plug #3 40' w/ 10 sx. cement

RECEIVED  
STATE CORPORATION COMMISSION  
12-28-1978  
DEC 28 1978  
CONSERVATION DIVISION  
WICHITA, KANSAS

(If additional description is necessary, use BACK of this sheet)

Name of Plugging Contractor John O. Farmer, Inc.

Address Box 352 Russell, Kansas 67665

STATE OF Kansas, COUNTY OF Russell, ss.  
John O. Farmer (employee of owner) or (owner or operator) of the above-described

well, being first duly sworn on oath, says: That I have knowledge of the facts, statements, and matters herein contained and the log of the above-described well as filed and that the same are true and correct. So help me God.

(Signature) John O. Farmer  
Box 352 Russell, Kansas 67665 (Address)

Subscribed and sworn to before me this 27th day of December, 1978

My commission expires February 15, 1979 Helen Carlson Notary Public.



15-195-20524-00-00

**KANSAS DRILLERS LOG**

API No. 15 — \_\_\_\_\_  
 County \_\_\_\_\_ Number \_\_\_\_\_

Operator  
 John O. Farmer, Inc.

Address  
 Box 352 Russell, Kansas 67665

Well No. #1 Lease Name Denning

Footage Location  
 660 feet from (N) (S) line 660 feet from (E) (W) line

Principal Contractor John O. Farmer, Inc. Geologist Sam L. Farmer

Spud Date 12-12-78 Total Depth 4055' P.B.T.D.


Date Completed 12-19-78 Oil Purchaser

S. 24 T. 11S R. 24W E

Loc. C NW SE

County Trego

640 Acres

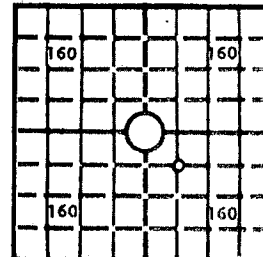

Elev.: Gr. 2441'

DF 2444' KB 2446'

**CASING RECORD**

Report of all strings set — surface, intermediate, production, etc.

Purpose of string	Size hole drilled	Size casing set (in O.D.)	Weight lbs/ft.	Setting depth	Type cement	Sacks	Type and percent additives
Surface	12 1/4	8-5/8"	26	216'	Common	175	

**LINER RECORD**

**PERFORATION RECORD**

Top, ft.	Bottom, ft.	Sacks cement	Shots per ft.	Size & type	Depth interval

**TUBING RECORD**

Size	Setting depth	Packer set at

**ACID, FRACTURE, SHOT, CEMENT SQUEEZE RECORD**

RECEIVED  
 STATE CORPORATION COMMISSION

Amount and kind of material used	Depth interval treated

DEC 28 1978  
 12-28-1978

CONSERVATION DIVISION  
 Wichita, Kansas

**INITIAL PRODUCTION**

Date of first production		Producing method (flowing, pumping, gas lift, etc.)			
RATE OF PRODUCTION PER 24 HOURS	Oil	Gas	Water	Gas-oil ratio	
	bbls.	CFB	bbls.	CFPB	
Disposition of gas (vented, used on lease or sold)			Producing interval(s)		

INSTRUCTIONS: As provided in KCC Rule 82-2-125, within 90 days after completion of a well, one completed copy of this Drillers Log shall be transmitted to the State Geological Survey of Kansas, 4150 Monroe Street, Wichita, Kansas 67209. Copies of this form are available from the Conservation Division, State Corporation Commission, 3830 So. Meridian (P.O. Box 17027), Wichita, Kansas 66217. Phone AC 316-522-2206. If confidential custody is desired, please note Rule 82-2-125. Drillers Logs will be on open file in the Oil and Gas Division, State Geological Survey of Kansas, Lawrence, Kansas 66044.

DESIGNATE TYPE OF COMP.: OIL, GAS,  
DRY HOLE, SWDW, ETC.:

Operator

John O. Farmer, Inc.

Well No.

#1

Lease Name

Denning

Dry Hole

S 24 T 11 S R 24 W E  
W

**WELL LOG**

Show all important zones of porosity and contents thereof; cored intervals, and all drill-stem tests, including depth interval tested, cushion used, time tool open, flowing and shut-in pressures, and recoveries.

SHOW GEOLOGICAL MARKERS, LOGS RUN,  
OR OTHER DESCRIPTIVE INFORMATION.

FORMATION DESCRIPTION, CONTENTS, ETC.	TOP	BOTTOM	NAME	DEPTH
Clay & Sand	-0-	110	Log Tops:	
Blue Shale	110	216		
Shale & Sand	216	1542	Anhydrite	2015' (+ 431)
Sand	1542	1768	Heebner	3770' (-1324)
Red Bed	1768	2017	Toronto	3796' (-1350)
Anhydrite	2017	2063	Lansing	3810' (-1364)
Shale & Shells	2063	2565	B/KC	4044' (-1598)
Shale & Lime	2565	3655	Log TD	4051' (-1605)
Lime & Shale	3655	3920	RTD	4055' (-1609)
Lime	3920	3988		
Lime & Shale	3988	4030		
Lime	4030	4055		

DST #1 3960' to 3988'  
Tool open 30-30-30-30; weak blow  
35 minutes  
Rec: 20' slightly oil cut mud  
IFP: 20-20 FFP: 20-30  
BHP: 40-20  
Drilling @ 4030'

USE ADDITIONAL SHEETS, IF NECESSARY, TO COMPLETE WELL RECORD.

Date Received

*John O. Farmer*  
Signature

President

Title

December 27, 1978

Date