

15-195-20285-00-00


STATE OF KANSAS  
STATE CORPORATION COMMISSION

Form CP-4

Give All Information Completely  
Make Required Affidavit  
Mail or Deliver Report to:  
Conservation Division  
State Corporation Commission

P. O. Box 17027  
Wichita, Kansas 67217  
NORTH

WELL PLUGGING RECORD

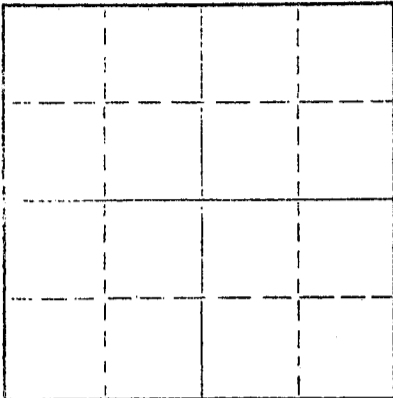

Locate well correctly on above  
Section Plat

Trego County. Sec. 24 Twp. 11S Rge. 24 (X) x (W)  
Location as "NE/CNWKSW¼" or footage from lines SE SE SE  
Lease Owner Rains & Williamson Oil Co., Inc.  
Lease Name Denning Well No. 1  
Office Address 435 Page Ct., 220 W. Douglas, Wichita, Ks. 67202  
Character of Well (completed as Oil, Gas or Dry Hole) Dry Hole  
Date well completed 10-14-74 19\_\_  
Application for plugging filed 10-13-74 19\_\_  
Application for plugging approved 10-13-74 19\_\_  
Plugging commenced 10-13-74 19\_\_  
Plugging completed 10-14-74 19\_\_  
Reason for abandonment of well or producing formation commercial quantities of oil not found.  
If a producing well is abandoned, date of last production 19\_\_  
Was permission obtained from the Conservation Division or its agents before plugging was commenced? Yes

Name of Conservation Agent who supervised plugging of this well W. L. Nichols-Morland, Kansas  
Producing formation \_\_\_\_\_ Depth to top \_\_\_\_\_ Bottom \_\_\_\_\_ Total Depth of Well 4040 Feet  
Show depth and thickness of all water, oil and gas formations.

OIL, GAS OR WATER RECORDS

CASING RECORD

FORMATION	CONTENT	FRGM	TO	SIZE	PUT IN	PULLED OUT
				8-5/8"	205'	

Describe in detail the manner in which the well was plugged, indicating where the mud fluid was placed and the method or methods used in introducing it into the hole. If cement or other plugs were used, state the character of same and depth placed, from \_\_\_\_\_ feet to \_\_\_\_\_ feet for each plug set.

Plugged @ 975' with 70 sx.  
245' with 20 sx.  
40' with 10 sx.

RECEIVED  
STATE CORPORATION COMMISSION  
OCT 23 1974  
CONSERVATION DIVISION  
Wichita, Kansas

(If additional description is necessary, use BACK of this sheet)

Name of Plugging Contractor Rains & Williamson Oil Co., Inc.  
Address 435 Page Court, 220 W. Douglas, Wichita, Kansas 67202

STATE OF KANSAS COUNTY OF SEDGWICK, ss.  
Wilson Rains, President (employee of owner) or (owner or operator) of the above-described

well, being first duly sworn on oath, says: That I have knowledge of the facts, statements, and matters herein contained and the log of the above-described well as filed and that the same are true and correct. So help me God.

(Signature) Wilson Rains  
WILSON RAINS  
435 Page Ct., Wichita, Ks. 67202  
(Address)

SUBSCRIBED AND SWORN to before me this 22nd day of October, 19 74

Juanita M. Green  
Juanita M. Green Notary Public.



My commission expires October 4, 1975

15-195-20285-00-00  
WELL LOG

COMPANY Rains & Williamson Oil Co., Inc.

SEC. 24 T. 11S R. 24W  
LOC. SE SE SE

FARM Denning NO. 1


RIG. NO. 7

TOTAL DEPTH 4040'

COMM. 10-6-74

COMP. 10-14-74

COUNTY Trego  
KANSAS

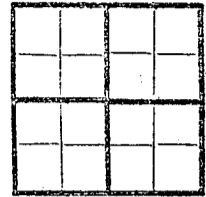

CONTRACTOR Rains & Williamson Oil Co., Inc.

CASING

20 10  
15 8-5/8" @ 205' w/150 sx. common.  
12 6  
13 5

ELEVATION 2429 KB

PRODUCTION D & A

FIGURES INDICATE BOTTOM OF FORMATIONS

Top Hole Soil	40
Shale	890
Shale and Sand	1920
Shale	2004
Anhydrite	2051
Shale	2340
Shale and Lime	3450
Lime and Shale	3570
Lime	4040
<u>Rotary Total Depth</u>	<u>4040</u>

RECEIVED  
STATE CORPORATION COMMISSION  
10-23-1974  
OCT 23 1974  
CONSERVATION DIVISION  
Wichita, Kansas

State of KANSAS }  
County of SEDGWICK } ss:

I, Wilson Rains, President of the Rains & Williamson Oil Co., Inc.

upon oath state that the above and foregoing is a true and correct copy of the log of the Denning #1 well.

Wilson Rains  
WILSON RAINS

Subscribed and sworn to before me this 22nd day of October 1974

My Commission Expires: October 4, 1975

Juanita M. Green  
NOTARY PUBLIC  
Juanita M. Green

