

15-195-21286-00-00

STATE OF KANSAS
STATE CORPORATION COMMISSION

WELL PLUGGING RECORD

Give All Information Completely
Make Required Affidavit
Mail or Deliver Report to
Conservation Division
State Corporation Comm.
245 North Water
Wichita, KS 67202

Trego County, Sec. 27 Twp. 11S Rge. 24 NE/W
Location as "NE/CNW}SW}" or footage from lines
NE SE NE

Lease Owner Mack Oil Co.
Lease Name Struss Well No. #1

Office Address 412 Union Center Bldg., Wichita, KS 67202
Character of Well (Completed as Oil, Gas or Dry Hole)

Dry Hole


Date Well completed 8-2-83 19
Application for plugging filed 8-1-83 19
Application for plugging approved 8-1-83 19
Plugging commenced 8-1-83 19
Plugging completed 8-2-83 19
Reason for abandonment of well or producing formation

Commercial quantities of oil not found

If a producing well is abandoned, date of last production 19.

Was permission obtained from the Conservation Division or its agents before plugging was commenced? Yes

Name of Conservation Agent who supervised plugging of this well Ed Shoemaker
Producing formation Depth to top Bottom Total Depth of Well 4100'
Show depth and thickness of all water, oil and gas formations.

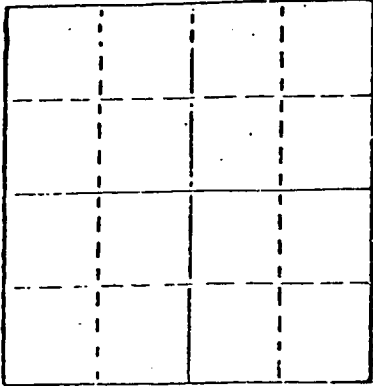

Locate well correctly on above Section Plat

OIL, GAS OR WATER RECORDS

CASING RECORD

FORMATION	CONTENT	FROM	TO	SIZE	PUT IN	PULLED OUT
				8 5/8"	340'	None

Describe in detail the manner in which the well was plugged, indicating where the mud fluid was placed and the method or methods used in introducing it into the hole. If cement or other plugs were used, state the character of same and depth placed, from _____ feet to _____ feet for each plug set.

- Plug @ 2050' w/20 sx.
- Plug @ 1158' w/100 sx.
- Plug @ 390' w/40 sx.
- Plug @ 40' w/10 sx.
- Rat Hole 10 sx.

RECEIVED
STATE CORPORATION COMMISSION
8-8-1983
AUG 08 1983
CONSERVATION DIVISION
WICHITA, KANSAS


(If additional description is necessary, use BACK of this sheet)

Name of Plugging Contractor Rains & Williamson Oil Co., Inc.

STATE OF Kansas COUNTY OF Sedgwick, ss.
Wilson Rains, President of Rains & Williamson Oil Co., (employee of owner) or (owner or operator) of the above-described well, being first duly sworn on oath, says: That I have knowledge of the facts, statements, and matters herein contained and the log of the above-described well as filed and that the same are true and correct. So help me God.

(Signature) Wilson Rains
435 Page Court, 220 W. Douglas, Wichita, KS 67202
(Address)

SUBSCRIBED AND SWORN TO before me this 3 day of August, 1983

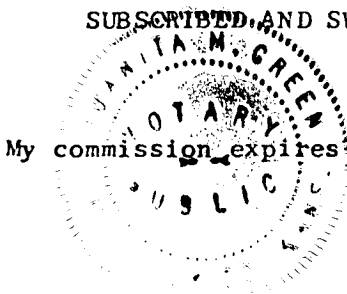

Juanita M. Green
Juanita M. Green Notary Public.

My commission expires 10-4-83