


STATE OF KANSAS  
STATE CORPORATION COMMISSION

15-195-00427-00-00

WELL PLUGGING RECORD

Give All Information Completely  
Make Required Affidavit  
Mail or Deliver Report to:  
Conservation Division  
State Corporation Commission  
212 North Market, Insurance Bldg.  
Wichita, Kansas

NORTH

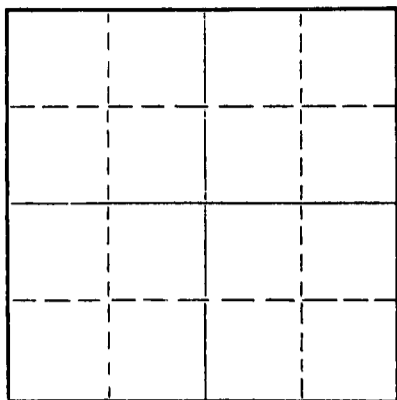

Locate well correctly on above  
Section Plat

Trego County, Sec 29 Twp. 11S Rge. (E) 24 (W)  
Location as "NE/CNWxSWx" or footage from lines C NW SE  
Lease Owner John O. Farmer, Inc.  
Lease Name Reeder Well No. 1  
Office Address 370 W. Wichita, Russell, Kansas  
Character of Well (completed as Oil, Gas or Dry Hole) Dry  
Date well completed \_\_\_\_\_ 19\_\_\_\_  
Application for plugging filed 5/19 1962  
Application for plugging approved 5/19 1962  
Plugging commenced 5/19 1962  
Plugging completed 5/19 1962  
Reason for abandonment of well or producing formation Dry

If a producing well is abandoned, date of last production \_\_\_\_\_ 19\_\_\_\_  
Was permission obtained from the Conservation Division or its agents before plugging was commenced? Yes

Name of Conservation Agent who supervised plugging of this well Elden Petty, Hays, Kansas  
Producing formation \_\_\_\_\_ Depth to top \_\_\_\_\_ Bottom \_\_\_\_\_ Total Depth of Well 4125 Feet  
Show depth and thickness of all water, oil and gas formations.


OIL, GAS OR WATER RECORDS

CASING RECORD

FORMATION	CONTENT	FROM	TO	SIZE	PUT IN	PULLED OUT

Describe in detail the manner in which the well was plugged, indicating where the mud fluid was placed and the method or methods used in introducing it into the hole. If cement or other plugs were used, state the character of same and depth placed, from \_\_\_\_\_ feet to \_\_\_\_\_ feet for each plug set.

First Plug at 540' with 20 sacks  
Second 160' with 15 sacks  
Third 40' with 10 sacks.

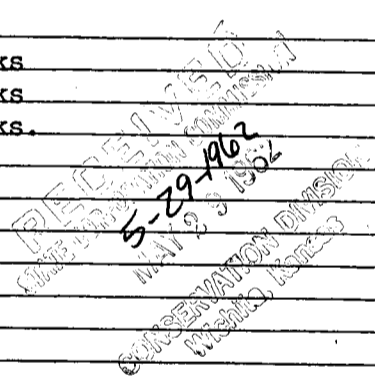

(If additional description is necessary, use BACK of this sheet)  
Name of Plugging Contractor John O. Farmer, Inc.  
Address P. O. Box 352, Russell, Kansas

STATE OF Kansas, COUNTY OF Russell, ss.  
John O. Farmer (employee of owner) or (owner or operator) of the above-described well, being first duly sworn on oath, says: That I have knowledge of the facts, statements, and matters herein contained and the log of the above-described well as filed and that the same are true and correct. So help me God.

(Signature) John O. Farmer  
President  
370 W. Wichita, Russell, Kansas  
(Address)

SUBSCRIBED AND SWORN TO before me this 28th day of May 19 62

My commission expires 5/18/62

