

STATE OF KANSAS  
STATE CORPORATION COMMISSION


Give All Information Completely  
Make Required Affidavit  
Mail or Deliver Report to:  
Conservation Division  
State Corporation Commission  
211 No. Broadway  
Wichita, Kansas

WELL PLUGGING RECORD

Russell County, Sec. 21 Twp. 11 Rge. 13 (E) (W) X

Location as "NE/CNWxSWx" or footage from lines C-NW SE  
Lease Owner Don McKellar Oil Explorations  
Lease Name Crawford Well No. 1  
Office Address Box # 173, Salina, Kansas - 67401  
Character of Well (completed as Oil, Gas or Dry Hole) Dry Hole  
Date well completed April 17, 19 64  
Application for plugging filed 19  
Application for plugging approved April 17, 19 64  
Plugging commenced April 16, 19 64  
Plugging completed April 17, 19 64  
Reason for abandonment of well or producing formation Dry

NORTH

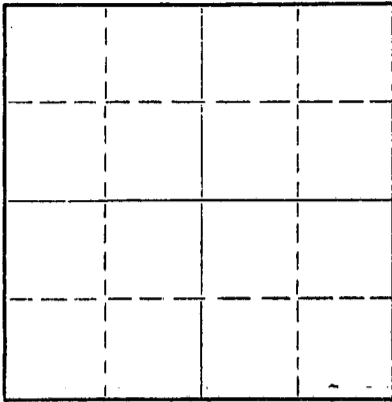

Locate well correctly on above  
Section Plat

If a producing well is abandoned, date of last production 19  
Was permission obtained from the Conservation Division or its agents before plugging was commenced? Yes

Name of Conservation Agent who supervised plugging of this well Donald Truan, Russell, Kansas  
Producing formation \_\_\_\_\_ Depth to top \_\_\_\_\_ Bottom \_\_\_\_\_ Total Depth of Well \_\_\_\_\_ Feet  
Show depth and thickness of all water, oil and gas formations.

OIL, GAS OR WATER RECORDS

CASING RECORD

FORMATION	CONTENT	FROM	TO	SIZE	PUT IN	PULLED OUT
Shale		0	30			
Lime		30	150			
Shale & Shells		150	275	8 5/8 in.	275'	None

Describe in detail the manner in which the well was plugged, indicating where the mud fluid was placed and the method or methods used in introducing it into the hole. If cement or other plugs were used, state the character of same and depth placed, from \_\_\_\_\_ feet to \_\_\_\_\_ feet for each plug set.

Set bottom plug at 270 ft. with 25 sacks cement,  
and set top plug at 40 ft. with 10 sacks cement.  
Hole plugging completed at 7:00 A.M., Apr. 17, 1964  
by Donald Truan, State Plugger, Russell, Kansas

RECEIVED  
STATE CORPORATION COMMISSION  
4-28-1964  
APR 28 1964

CONSERVATION DIVISION  
Wichita, Kansas

(If additional description is necessary, use BACK of this sheet)

Name of Plugging Contractor Blackstone Drilling, Kx Inc.  
Address Box # 455, McPherson, Kansas - 67460

STATE OF Kansas, COUNTY OF Saline, ss.  
Don McKellar

(Operator) of the above-described well, being first duly sworn on oath, says: That I have knowledge of the facts, statements, and matters herein contained and the log of the above-described well as filed and that the same are true and correct. So help me God.

(Signature) Don McKellar

Box #173, Salina, Kansas - 67401

(Address)

Subscribed and sworn to before me this 24<sup>th</sup> day of April, 19 64



Rosemary Miller

Notary Public.



# Blackstone Drilling, Inc.

Box 455 • 523 West Kansas • Phone CH 1-1250

McPHERSON • KANSAS

April 20, 1964

COMPANY: DON MC KELLAR OIL EXPLORATIONS  
 CONTRACTOR: BLACKSTONE DRILLING, INC.  
 FARM: CRAWFORD #1  
 LOCATION: C-13W/4 SE/4, Sec. 21-11-13W,  
 Russell County, Kansas  
 COMMENCED: April 9, 1964  
 COMPLETED: April 17, 1964  
 ELEVATION: 1724 K. B.

0	to	30	Shale
30	to	150	Lime
150	to	275	Shale & Shells
275	to	950	Shale
950	to	1440	Shale & Shells
1440	to	1840	Lime
1840	to	2158	Lime & Shale
2158	to	2420	Shale & Lime
2420	to	2460	Tarkio Lime
2460	to	2745	Shale & Lime
2745	to	2925	Lime
2925	to	3030	Shale & Lime
3030	to	3252	Lime
		3252	T. D.

**RECEIVED**  
 STATE CORPORATION COMMISSION  
 4-28-1964  
 APR 28 1964  
 CONSERVATION DIVISION  
 Wichita, Kansas

Cut 12 1/4 in. hole to 275 ft. and run 277 ft. of 8 5/8 in. Surface pipe and cemented with 100 sacks on bottom at 275 ft. Plug down at 3:00 P.M., April 19, 1964. Cut 7 7/8 in. hole to 3252 ft. Hole dry and abandoned. Set bottom plug at 270 ft. with 25 sacks cement, and set top plug at 40 ft. with 10 sacks cement. Hole plugging completed at 7:00 A.M., April 17, 1964 by Donald Truan, State Plugger, Russell, Kansas.

TOPS: Neva - 2055' 1st. Tarkio Sand - 2372' heebner Shale - 2940'  
 Brown Lime - 2995' Lansing - Kansas City Lime - 3022'

Measurements taken from K. B.

### CERTIFICATE

I, H. J. Plouffe, President of Blackstone Drilling, Inc. do hereby certify that the above and foregoing is a true and correct copy of log on your Crawford #1, located on the C-13W/4 SE/4 of Sec. 21-11-13W, Russell County, Kansas as reflected by the files of Blackstone Drilling, Inc.

H. J. Plouffe - President

Subscribed and sworn to before me a Notary Public, in and for McPherson County, Kansas this 21st Day of April, 1964.

Ruth McVay, Notary Public



My Commission Expires: Dec. 18, 1965.