


WELL PLUGGING RECORD

Give All Information Completely  
Make Required Affidavit  
Mail or Deliver Report to:  
Conservation Division  
State Corporation Commission  
800 Biting Building  
Wichita, Kansas

NORTH

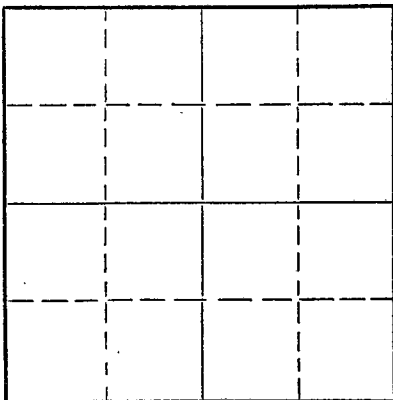

Locate well correctly on above  
Section Plat

Trego County, Sec. 19 Twp. 11S Rge. 22W (E) (W)

Location as "NE/CNW%SW%" or footage from lines NW NW NE

Lease Owner PAM-KAR DRILLING CO., INC.

Lease Name Hixon Well No. 1

Office Address 333 1st National Bk. Bldg. Wichita, Kansas

Character of Well (completed as Oil, Gas or Dry Hole)

Date well completed July 8 1953

Application for plugging filed September 22 1953

Application for plugging approved September 24 1953

Plugging commenced September 25 1953

Plugging completed September 30 1953

Reason for abandonment of well or producing formation D & A

If a producing well is abandoned, date of last production 19

Was permission obtained from the Conservation Division or its agents before plugging was commenced? Yes

Name of Conservation Agent who supervised plugging of this well Eldon Petty

Producing formation None Depth to top Bottom Total Depth of Well 3952' Feet

Show depth and thickness of all water, oil and gas formations.

OIL, GAS OR WATER RECORDS

CASING RECORD

FORMATION	CONTENT	FROM	TO	SIZE	PUT IN	PULLED OUT
				8-5/8"	185'	None
				5-1/2"	3942'	3429'

Describe in detail the manner in which the well was plugged, indicating where the mud fluid was placed and the method or methods used in introducing it into the hole. If cement or other plugs were used, state the character of same and depth placed, from feet to feet for each plug set.

Filled hole with sand from 3913' to 3800' and ran 4 sacks of cement on top of sand. Mudded hole to 185', set a 10' rock bridge and ran 15 sacks of cement. Mudded hole to top and ran 10 sacks of cement. Plugging completed.

Name of Plugging Contractor West Supply Company  
Address Chase, Kansas

STATE OF KANSAS, COUNTY OF SEDGWICK, ss.  
Ralph B. McLaughlin (employee of owner) or (owner or operator) of the above-described

well, being first duly sworn on oath, says: That I have knowledge of the facts, statements, and matters herein contained and the log of the above-described well as filed and that the same are true and correct. So help me God.


(Signature) Ralph B. McLaughlin

(Address)

SUBSCRIBED AND SWORN to before me this 3 day of Oct. 1953

Sept. 4, 1957

Notary Public.

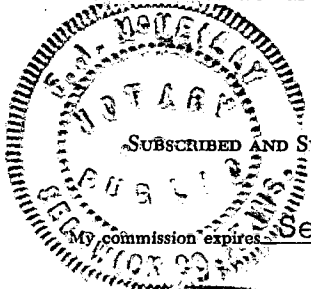

24-7968-S 3-53-20M

PLUGGING  
FILE SEC 9 T 11 R 224  
BOX PAGE 133 LINE 34

RECEIVED  
STATE CORPORATION COMMISSION  
10-6-1953  
OCT-6-1953

CONSERVATION DIVISION  
Wichita

15-195-00051-00-00

PAM-KAR DRILLING COMPANY, INC.

Wichita, Kansas

Well: Hixson #1

NW NW NE, Sec 9-11E-22N  
Trego County, Kansas

Commenced RD : 6-25-53  
Completed RD : 7-8-53

Elevation: 2208 DF  
2210 RB

Total Depth : 3952'

Casings: 185' of 8-5/8" 24# OD Csg  
3942' of 5-1/2" 14# OD Csg

Contractor: Pam-Kar Drlg Co.

STRATA	DEPTH	TOPS	
Sand	55		
Sand, rock, sand & shale	130	Heebner	3439 -1229
Shale & shells	190	Lansing-K. C.	3474 -1264
Shale	280	Base K. C.	3710
Sand	310	Marmaton Lime	3799
Shale	1005	Cherty Conglomerate	3848
Sand	1040	Arbuckle	3935 -1725
Shale & shells	1250		
Sand	1435		
Red Bed	1663		
Anhydrite	1690		
Shale	1920		
Shale & Sandy Lime	2010		
Shale & Shells	2335		
Shale & Sandy Lime	2420		
Lime & Shale	3532		
Lime	3565		
Lime & Shale	3661		
Lime	3709		
Lime & Shale	3802		
Lime & Chert	3842		
Lime, shale & Chert	3846		
Lime, sand-shale	3892		
Lime, shale & chert	3932		
Lime & Chert	3952		

I hereby certify that the above is a true and correct log of said well as reflected by the Daily Drilling Reports.

PAM-KAR DRILLING COMPANY, INC.

By

*Ralph B. McLaughlin*

Signed and sworn to in my presence this 8th day of July, 1953, by Ralph B. McLaughlin, Secretary-Treasurer of the Pam-Kar Drilling Company, Inc. a corporation in the state of Kansas.



*Irene F. Stewart*  
Notary Public

My commission expires Jan 6, 1954.

10-6-1953

**PLUGGING**  
FILE SEC 9 T 11 R 22a  
OK PAGE 133 LINE 34