

CARD MUST BE TYPED

State of Kansas
NOTICE OF INTENTION TO DRILL

CARD MUST BE SIGNED

(see rules on reverse side)

Starting Date: ... August 20, 1985 ...
month day year

API Number 15- **195-21,763-00-00** East

OPERATOR: License # ..5046.....

C. - SE/4 ... Sec 18 Twp 11 S, Rge 23. West
(location)

Name ..Raymond Oil Company, Inc.....

Address ...One Main Place, #900.....

City/State/Zip ...Wichita, Kansas....67202.....

Contact Person ..Pat Raymond.....

Phone316-267-4214.....

.....1320.... Ft North from Southeast Corner of Section

.....1320.... Ft West from Southeast Corner of Section

(Note: Locate well on Section Plat on reverse side)

CONTRACTOR: License #5652.....

Nearest lease or unit boundary line1320..... feet.

County ...Trego.....

Name ...Mustang Drilling & Exploration, Inc.....

Lease Name ..Walker "A"..... Well# 1.....

City/State ..Great Bend, Ks....67530.....

Domestic well within 330 feet : yes no

Municipal well within one mile : yes no

Well Drilled For: Well Class: Type Equipment:

- Oil Swd Infield Mud Rotary
- Gas Inj Pool Ext. Air Rotary
- OWWO Expl Wildcat Cable

Depth to Bottom of fresh water100..... feet

Lowest usable water formation ...Dakota.....

Depth to Bottom of usable water200..... ~~1100~~ feet

If OWWO: old well info as follows:

Surface pipe by Alternate : 1 2

Operator

Surface pipe to be set200..... feet

Well Name

Conductor pipe if any requirednone..... feet

Comp Date Old Total Depth

Ground surface elevation ...Est. 2355..... feet MSL

Projected Total Depth .3975..... feet

This Authorization Expires2-6-86.....


Projected Formation at TDBKC.....

Approved By8-6-85.....

Expected Producing Formations ...LKC.....

I certify that we will comply with K.S.A. 55-101, et seq., plus eventually plugging hole to K.C.C. specifications.

Date July 10, 1985 Signature of Operator or Agent

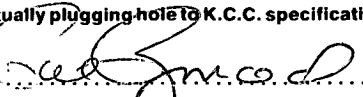 Title Vice President.....
Pat Raymond

REH SURKONE

RECEIVED
STATE CORPORATION COMMISSION


This document must be filed with the K.C.C. five (5) days prior to commencing well operations. It is void if drilling not started within six (6) months of date received by K.C.C.

AUG 6 1985

8-6-1985

CONSERVATION DIVISION
A Regular Section of Land
Wichita, Kansas

1 Mile = 5,280 Ft.

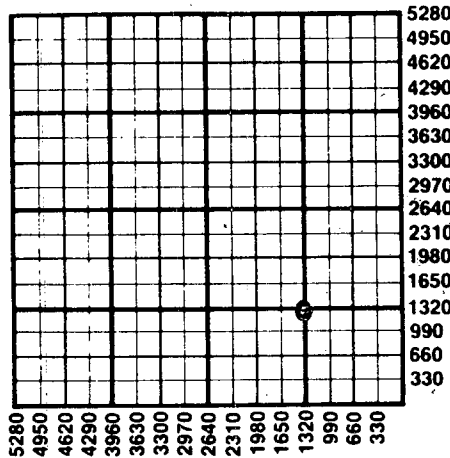

Important procedures to follow :

1. Notify District office before setting surface casing.
2. Set surface casing by circulating cement to the top.
3. File completion forms ACO-1 with K.C.C. within 90 days of well completion, following instructions on ACO-1, side 1, and including copies of wireline logs.
4. Notify District office 48 hours prior to old well workover or re-entry.
5. Prior to plugging, prepare a plugging plan, then obtain agreement from the appropriate district office for an approved plugging plan.
6. Submit plugging report (CP-4) to K.C.C. after plugging is completed.
7. Obtain an approved injection docket number before disposing of salt water.
8. Notify K.C.C. within 10 days when injection commences or terminates.
9. If an alternate 2 completion, cement in the production pipe from below any usable water to surface within 120 days of spud date.

State Corporation Commission of Kansas
Conservation Division
200 Colorado Derby Building
Wichita, Kansas 67202
(316) 263-3238