

CARD MUST BE TYPED

NOTICE OF INTENTION TO DRILL

(see rules on reverse side)

CARD MUST BE SIGNED

15-195-21726-00-00

CORRECTION  
6-11-85

Starting Date: June 16 1985  
month day year

API Number 15- 195-21,726-00-00 Correction

OPERATOR: License # 8449  
Name McNames & Patterson  
Address P.O. Box 20058  
City/State/Zip Wichita, Ks  
Contact Person Gary Patterson  
Phone 733-5750

~~W2~~ NW NE  
Sec 26 Twp 11s S, Rge 23  
 East  
 West

\* 4950 Ft North from Southeast Corner of Section  
2310 Ft West from Southeast Corner of Section  
(Note: Locate well on Section Plat on reverse side)

CONTRACTOR: License # 5655  
Name Shields Drlg.  
City/State Russell, Ks

Nearest lease or unit boundary line 330 feet.  
County Trego  
Lease Name Buchholz Well# #1

Well Drilled For: Well Class: Type Equipment:  
 Oil  Swd  Infield  Mud Rotary  
 Gas  Inj  Pool Ext.  Air Rotary  
 OWWO  Expl  Wildcat  Cable

Domestic well within 330 feet:  yes  no  
Municipal well within one mile:  yes  no

If OWWO: old well info as follows:


Operator  
Well Name  
Comp Date Old Total Depth  
Projected Total Depth 4100 feet  
Projected Formation at TD Arbuckle  
Expected Producing Formations Lansing-KC

Depth to Bottom of fresh water  
Lowest usable water formation *Dg Kofa*  
Depth to Bottom of usable water 925 feet  
Surface pipe by Alternate: *1 2 2 2 2*  
Surface pipe to be set 925-250 feet  
Conductor pipe if any required none feet  
Ground surface elevation 2318 feet MSL  
This Authorization Expires 11-15-85  
Approved By 5-15-85

I certify that we will comply with K.S.A. 55-101, et seq., plus eventually plugging hole to K.C.C. specifications. *was w/2 NW NE 4620 FSL*  
Date June 5, 1985 Signature of Operator or Agent Gary Patterson Title Partner *Alt #2 250' surf.*

Must be filed with the K.C.C. five (5) days prior to commencing well  
This card void if drilling not started within six (6) months of date received by K.C.C.

A Regular Section of Land  
1 Mile = 5,280 Ft.

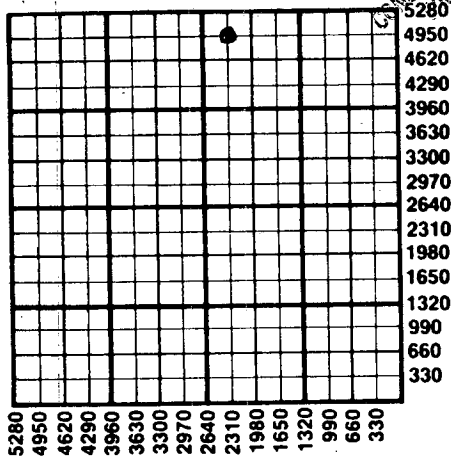

**Important procedures to follow:**

1. Notify District office before setting surface casing.
2. Set surface casing by circulating cement to the top.
3. File completion forms ACO-1 with K.C.C. within 90 days of well completion, following instructions on ACO-1, side 1, and including copies of wireline logs.
4. Notify District office 48 hours prior to old well workover or re-entry.
5. Prior to plugging, prepare a plugging plan, then obtain agreement from the appropriate district office for an approved plugging plan.
6. Submit plugging report (CP-4) to K.C.C. after plugging is completed.
7. Obtain an approved injection docket number before disposing of salt water.
8. Notify K.C.C. within 10 days when injection commences or terminates.
9. If an alternate 2 completion, cement in the production pipe from below any usable water to surface within 120 days of spud date.

State Corporation Commission of Kansas  
Conservation Division  
200 Colorado Derby Building  
Wichita, Kansas 67202  
(316) 263-3238