

CARD MUST BE TYPED

State of Kansas
NOTICE OF INTENTION TO DRILL

CARD MUST BE SIGNED

(see rules on reverse side)

Starting Date: August 19 85
(month day year)

API Number 15- 195-21,755-00-00

OPERATOR: License # 9011
Name Joseph H. Strabala
Address 312 E. Uintah St.
City/State/Zip Colorado Springs, Colo. 80903
Contact Person Don H. Kinderknecht
Phone 913-625-1185

APPR. NW 1/4 SE 1/4 SE 1/4 Sec 30 Twp 11 S, Rge 23
(location) East West

CONTRACTOR: License # 9087
Name R. & C. Drilling Co. Inc.
City/State Hays, Kansas P.O.B. 296 67601

900 Ft North from Southeast Corner of Section
790 Ft West from Southeast Corner of Section
(Note: Locate well on Section Plat on reverse side)

Well Drilled For: Well Class: Type Equipment:
 Oil Swd Infield Mud Rotary
 Gas Inj Pool Ext. Air Rotary
 OWWO Expl Wildcat Cable

Nearest lease or unit boundary line 790 feet.
County Trego
Lease Name Rhoades Well# 1
Domestic well within 330 feet: yes no
Municipal well within one mile: yes no

If OWWO: old well info as follows:
Operator
Well Name
Comp Date Old Total Depth
Projected Total Depth 4300 feet
Projected Formation at TD Arbuckle
Expected Producing Formations Kansas City

Depth to Bottom of fresh water 100 feet
Lowest usable water formation ~~Missouri~~ Dakota
Depth to Bottom of usable water 950 feet
Surface pipe by Alternate: 1 2
Surface pipe to be set 220 feet
Conductor pipe if any required None feet
Ground surface elevation Approx 2350 feet MSL
This Authorization Expires 1-25-86
Approved By RCH 7-25-85


I certify that we will comply with K.S.A. 55-101, et seq., plus eventually plugging hole to K.C.C. specifications.

Date July 23, 1985 Signature of Operator or Agent Joseph H. Strabala Title Operator

Must be filed with the K.C.C. five (5) days prior to commencing well
This card void if drilling not started within six (6) months of date received by K.C.C.

Important procedures to follow :

**A Regular Section of Land
1 Mile = 5,280 Ft.**

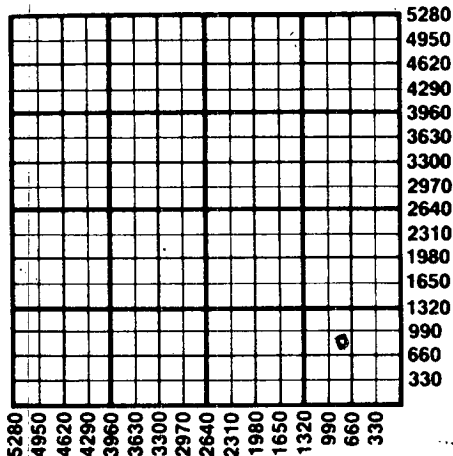

1. Notify District office before setting surface casing.
2. Set surface casing by circulating cement to the top.
3. File completion forms ACO-1 with K.C.C. within 90 days of well completion, following instructions on ACO-1, side 1, and including copies of wireline logs.
4. Notify District office 48 hours prior to old well workover or re-entry.
5. Prior to plugging, prepare a plugging plan, then obtain agreement from the appropriate district office for an approved plugging plan.
6. Submit plugging report (CP-4) to K.C.C. after plugging is completed.
7. Obtain an approved injection docket number before disposing of salt water.
8. Notify K.C.C. within 10 days when injection commences or terminates.
9. If an alternate 2 completion, cement in the production pipe from below any usable water to surface within 120 days of spud date.

7-25-1985
JUL 25 1985

Conservation Division
Wichita, Kansas

State Corporation Commission of Kansas
Conservation Division
200 Colorado Derby Building
Wichita, Kansas 67202
(316) 263-3238