Kansas Corporation Commission Oil & Gas Conservation Division

P . .


WELL PLUGGING APPLICATION

Please TYPE Form and File ONE Copy

Form CP-1 September 2003 This Form must be Typed Form must be Signed All blanks must be Filled

API # 15 - 007-21275 -000	(Identifier Number of this well)	. This must be listed for wells drilled	since 1967; if no API # was issued,
indicate original spud or completion date 9/29/81			
Wall Common FALCON EXPLORATION INC.		KCC License #: 5316	
Address: 125 N. MARKET, SUITE 125	wner / Company Name) 2	City:_WICHITA	(Operator s)
State: KS		Contact Phone: (316) 26	62 - 1378
Lease: HOAGLAND	Well-#:	Sec. 36 Twp. 31	S. R. 12 East West
NE - NW - NE -	_Spot Location / QQQQ Cour	nty:_BARBER	
Feet (in exact footage) From Feet (in exact footage) From Check One: Oil Well Gas Well	East / West (from near	rest outside section comer) Line of Sec rest outside section comer) Line of Sec Water Supply Well	tion (Not Lease Line)
SWD Docket #			
Conductor Casing Size:	•		
Surface Casing Size: 8-5/8"			
Production Casing Size: 4-1/2			
List (ALL) Perforations and Bridgeplug Sets: PE	RFS:4360-70;4372-74;4371-	75'. PLUG: 4410', CIBP: 4370	
Elevation: 1601 (G.L. / K.B.) T.D.: 44	50 PBTD: 4417 A	nhydrite Depth:	ne Corral Formation)
Condition of Well: Good Poor	r Casing Leak J	unk in Hole	ne Corrai Formation)
Proposed Method of Plugging (attach a separate page	ge if additional space is needed): PEF	R KCC INSTRUCTIONS	
			RECEIVED ANSAS CORPORATION COMMISSIO
Is Well Log attached to this application as required		d? 🔽 Yes 🗌 No	APR 0 7 2009
If not explain why?			CONSERVATION DIVISION WICHITA, KS
Plugging of this Well will be done in accordance	with K.S.A. 55-101 et. seq. and the	e Rules and Regulations of the Stat	e Corporation Commission.
List Name of Company Representative authorized	to be in charge of plugging operation	ns: LEON KUHN	
			1559
Address: P O BOX 551		City / State: RUSSELL, KS 67665	
Plugging Contractor: H-D OILFIELD		KCC License #: 32970 (Contractor's)	
Address: P O BOX 87, BAZINE KS	Company Name)	Phone: (785) 398 -	2289
Proposed Date and Hour of Plugging (if known?):	APRIL 9, 2009		×`
Payment of the Plugging Fee (K.A.R. 82-3-118) v		gent	· 8/
Date: 4/7/09 Authorized Operato	r / Agent:	(Signature)	
		(organization of	, DA

Mail to: KCC - Conservation Division, 130 S. Market - Room 2078, Wichita, Kansas 67202

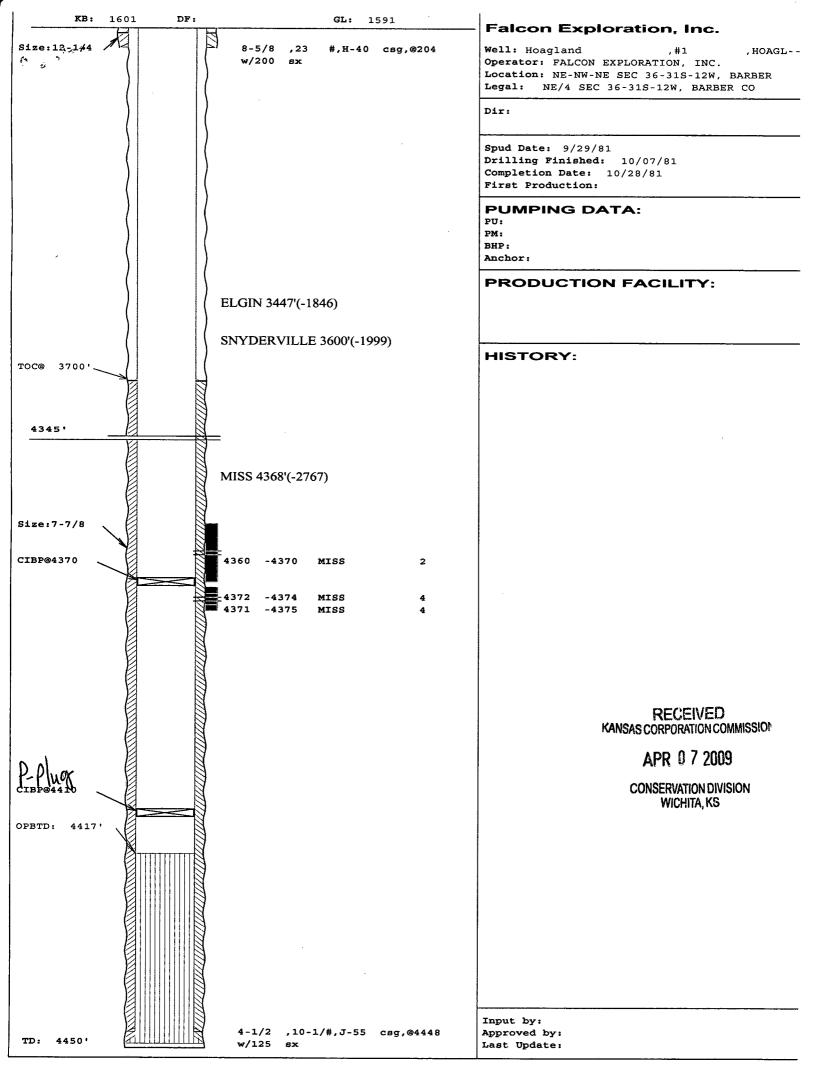



Kathleen Sebelius, Governor Thomas E. Wright, Chairman Michael C. Moffet, Commissioner Joseph F. Harkins, Commissioner

NOTICE OF RECEIPT OF WELL PLUGGING APPLICATION (CP-1)

FALCON EXPLORATION, INC. 125 N MARKET STE 1252 WICHITA, KS 67202-1719 April 13, 2009

Re: HOAGLAND #1

API 15-007-21275-00-00

36-31S-12W, 4964 FSL 1674 FEL BARBER COUNTY, KANSAS

Dear Operator:

This letter is to notify you that the Conservation Division has received your plugging proposal, form CP-1, for the above well and has reviewed the proposal for completeness. The central office will now forward your CP-1 to the district office listed below for review of the proposed plugging method. Please contact the district office for approval of your proposed plugging method at least five (5) days before plugging the well, pursuant to K.A.R. 82-3-113(b). If a workover pit will be used during the plugging of the well it must be permitted. A CDP-1 form must be filed and approved prior to the use of the pit in accordance with K.A.R. 82-3-600.

The Conservation Division's review of form CP-1, either in the central or district office, does not include an inquiry into well ownership or the filing operator's legal right to plug the well. This notice in no way constitutes authorization to plug the above well by persons not having legal rights of ownership or interest in the well.

This notice is void after October 10, 2009. The CP-1 filing does not bring the above well into compliance with K.A.R. 82-3-111 with regard to the Commission's temporary abandonment requirements.

Sincerely,

Steve Bond

Production Department Supervisor

District: #1 210 E Frontview, Suite A Dodge City, KS 67801 (620) 225-8888