

STATE OF KANSAS
STATE CORPORATION COMMISSION

15-195-20374-00-00


Form CP-4

Give All Information Completely
Make Required Affidavit
Mail or Deliver Report to:
Conservation Division
State Corporation Commission
P. O. Box 17027
Wichita, Kansas 67217
NORTH

WELL PLUGGING RECORD

Trego County, Sec. 34 Twp. 11S Rge. (E) 23 (W)

Location as "NE/CNWxSWx" or footage from lines C W/2 NE NW
Lease Owner Chief Drilling Co., Inc.
Lease Name Rhoades Well No. #1
Office Address 905 Century Plaza, Wichita, Kansas 67202
Character of Well (completed as Oil, Gas or Dry Hole) Dry Hole
Date well completed 7/13/76 19
Application for plugging filed 7/13/76 19
Application for plugging approved 7/13/76 19
Plugging commenced 7/13/76 19
Plugging completed 7/13/76 19
Reason for abandonment of well or producing formation Dry Hole

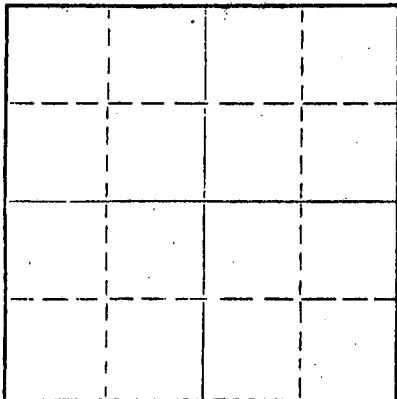

Locate well correctly on above Section Plat

If a producing well is abandoned, date of last production 19
Was permission obtained from the Conservation Division or its agents before plugging was commenced? Yes

Name of Conservation Agent who supervised plugging of this well Leo Massey
Producing formation Depth to top Bottom Total Depth of Well 3925 Feet
Show depth and thickness of all water, oil and gas formations.

OIL, GAS OR WATER RECORDS

CASING RECORD

FORMATION	CONTENT	FROM	TO	SIZE	PUT IN	PULLED OUT
		0	226'	8 5/8"		

Describe in detail the manner in which the well was plugged, indicating where the mud fluid was placed and the method or methods used in introducing it into the hole. If cement or other plugs were used, state the character of same and depth placed, from feet to feet for each plug set.

Plugged through drill pipe @ 1000' w/70 sx. cement
Plugged through drill pipe @ 215' w/20 sx. cement
Plugged through drill pipe @ 40' w/10 sx. cement

RECEIVED
STATE CORPORATION COMMISSION
7-20-1976
JUL 20 1976
CONSERVATION DIVISION
Wichita, Kansas

(If additional description is necessary, use BACK of this sheet)

Name of Plugging Contractor Chief Drilling Co., Inc.
Address 905 Century Plaza, Wichita, Kansas 67202

STATE OF KANSAS, COUNTY OF SEDGWICK, ss.
Jim Robinson (Employee of owner) or (owner or operator) of the above-described

well, being first duly sworn on oath, says: That I have knowledge of the facts, statements, and matters herein contained and the log of the above-described well as filed and that the same are true and correct. So help me God.

(Signature) Jim Robinson
905 Century Plaza, Wichita, Ka. 67202
(Address)

SUBSCRIBED AND SWORN TO before me this 14th day of July, 1976

My commission expires

MARILYN SINARD
STATE NOTARY PUBLIC
SEDGWICK COUNTY, KANSAS
MY COMM. EXP. APR. 30, 1979

Marilyn Sinard
Notary Public.

WELL LOG

15-195-20374-00-00

CHIEF DRILLING CO., INC.
905 Century Plaza
Wichita, Kansas 67202

#1 RHOADES
C W/2 NE NW Sec. 34-11S-23W
Trego County, Kansas

CONTRACTOR: Company Tools
CASING RECORD: 8 5/8" @ 226' w/165 sx.

COMMENCED: 7/6/76
COMPLETED: 7/13/76

FORMATION	FROM	TO	ELEVATIONS
Surface Hole	0	330	2410 Gr.
Shale & Sand	330	1611	2412 D.F.
Sand & Shale	1611	2090	2415 K.B.
Shale	2090	3545	
Lime	3545	3925	
Total Depth	3925		

FORMATION TOPS	
Anhydrite	1884 + 531
Base Anhydrite	1937 + 478
Heebner	3656 - 1241
Toronto	3674 - 1259
Lansing	3688 - 1273
Base K.C.	3917 - 1502
RTD	3925 - 1510

RECEIVED
STATE CORPORATION COMMISSION
7-20-1976
JUL 20 1976

CONSERVATION DIVISION
Wichita, Kansas

STATE OF KANSAS, COUNTY OF SEDGWICK) ss:

I hereby certify that the above is a true and correct copy of the Driller's Log of the well drilled in the C W/2 NE NW Section 34-11S-23W, Trego County, Kansas, to the best of my knowledge and belief.

CHIEF DRILLING CO., INC.

Jim Robinson
Jim Robinson, Vice-President

Subscribed and sworn to before me this 19th day of July, 1976

MARILYN SINARD
STATE NOTARY PUBLIC
SEDGWICK COUNTY, KANSAS
MY COMM. EXP. APR. 30, 1979

Marilyn Sinard
Marilyn Sinard Notary Public