


Give All Information Completely
Make Required Affidavit
Mail or Deliver Report to:
Conservation Division
State Corporation Commission
211 No. Broadway
Wichita, Kansas

WELL PLUGGING RECORD

NORTH

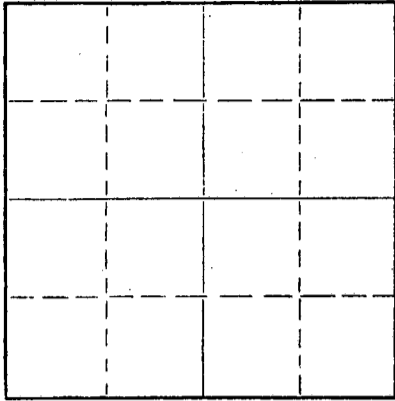

Locate well correctly on above
Section Plat

Trego

County. Sec. 34 Twp. 11S Rge. 23W (X) (W)

Location as "NE/CNW%SW%" or footage from lines. NW NE NE

Lease Owner Leben Drilling, Inc. & Bankoff Oil Co.

Lease Name Howat Well No. 1

Office Address 905 Central Building, Wichita, Kansas

Character of Well (completed as Oil, Gas or Dry Hole) Dry Hole

Date well completed 10-26-57 19

Application for plugging filed 10-26-57 19

Application for plugging approved 10-26-57 19

Plugging commenced 10-26-57 19

Plugging completed 10-26-57 19

Reason for abandonment of well or producing formation Dry Hole

If a producing well is abandoned, date of last production - 19

Was permission obtained from the Conservation Division or its agents before plugging was commenced? Yes

Name of Conservation Agent who supervised plugging of this well Eldon Petty

Producing formation _____ Depth to top _____ Bottom _____ Total Depth of Well _____ Feet

Show depth and thickness of all water, oil and gas formations.

OIL, GAS OR WATER RECORDS

CASING RECORD

FORMATION	CONTENT	FROM	TO	SIZE	PUT IN	PULLED OUT
				8 5/8"	250'	

Describe in detail the manner in which the well was plugged, indicating where the mud fluid was placed and the method or methods used in introducing it into the hole. If cement or other plugs were used, state the character of same and depth placed, from _____ feet to _____ feet for each plug set.

1st Plug @ 600' w/20 sacks cement
2nd Plug @ 240' w/20 sacks cement
Top Plug @ 40' w/10 sacks cement

(If additional description is necessary, use BACK of this sheet)

Name of Plugging Contractor Leben Drilling, Inc.

Address 905 Central Building, Wichita, Kansas

STATE OF Kansas, COUNTY OF Sedgwick, SS. L. Frank Hamlin, employee (employee of owner) or (~~XXXXXX~~) of the above-described

well, being first duly sworn on oath, says: That I have knowledge of the facts, statements, and matters herein contained and the log of the above-described well as filed and that the same are true and correct. So help me God.

(Signature) Frank Hamlin

905 Central Building, Wichita, Kansas
(Address)

SUBSCRIBED AND SWORN to before me this 29th day of October, 19 57

My commission expires June 17, 1961

Ruth N. Benjamin Notary Public.

PLUGGING
FILE SEC. 34 T. 11 R. 23W
BOOK PAGE 57 LINE 8

REC-
STATE CORPORATION COMMISSION
11-1-1957
NOV 1 1957
CONSERVATION DIVISION
Wichita, Kansas

DRILLER'S LOG

COMPANY: LEBEN DRILLING, INC. & BANKOFF OIL CO.
 CONTRACTOR: LEBEN DRILLING, INC.
 FARM: HOWAT #1
 LOCATION: NW $\frac{1}{4}$ NE $\frac{1}{4}$ NE $\frac{1}{4}$ SEC. 34-11S-23W
 TREGO COUNTY, KANSAS
 COMMENCED: 10-15-57
 COMPLETED: 10-26-57

0	220	Shale & Sand	
220	251	Shale	
251	1010	Shale & Sand	TOPS:
1010	1100	Shale	Anhydrite 1875
1100	1190	Sand	Topeka 3416
1190	1330	Shale	Heebner 3641
1330	1610	Sand	Toronto 3661
1610	1620	Shale	Lansing 3676
1620	1650	Shale	Bs. K.C. 3907
1650	1875	Redbed	
1875	1905	Anhydrite	Elevation 2402 K.B.
1905	1913	Anhydrite	
1913	2160	Shale & Lime Stks.	
2160	2415	Shale & Shells	
2415	3205	Lime & Shale	
3205	3641	Shale & Lime	
3641	3644	Heebner	
3644	3665	Lime & Shale	
3665	3675	Shale	
3675	3920	Lime	
	3920	<u>Rotary Total Depth - D & A</u>	

Set 250' of 8 5/8" surface casing with 175 sacks cement & 4 sacks CaCl.

I, Frank Hamlin, do hereby certify that the above and foregoing is a true and correct copy of the log of the Howat #1, located NW $\frac{1}{4}$, NE $\frac{1}{4}$ NE $\frac{1}{4}$ of Section 34, Township 11 South, Range 23 West, Trego County, Kansas, as reflected by the files of Leben Drilling, Inc.

LEBEN DRILLING, INC.

By: Frank Hamlin
 Frank Hamlin

STATE OF KANSAS)
) SS
 COUNTY OF SEDGWICK)

Subscribed and sworn to before me, a Notary Public, in and for Sedgwick County, Kansas, this 29th day of October, 1957.

Ruth N. Benjamin
 Ruth N. Benjamin, Notary Public

My commission expires:
 June 17, 1961

PLUGGING
 FILE SEC. 34 T. 11 R. 23W
 BOOK PAGE 57 LINE 8

STATE OF KANSAS
 11-1-1957
 NOV 1 1957
 COMMISSION EXPIRES
 JUN 17 1961