


WELL PLUGGING RECORD

Give All Information Completely
Make Required Affidavit
Mail or Deliver Report to:
Conservation Division
State Corporation Commission
800 Bitting Building
Wichita, Kansas

NORTH

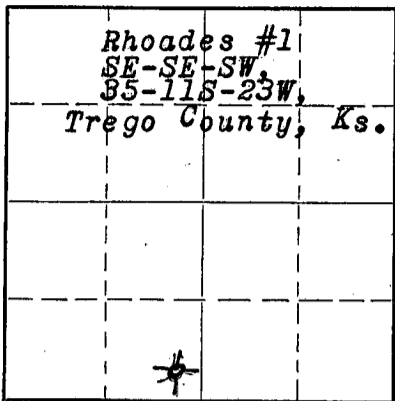

Locate well correctly on above Section Plat

Trego County, Sec. 35 Twp. 11S Rge. 23W (E).....(W)
Location as "NE/CNW $\frac{1}{4}$ SW $\frac{1}{4}$ " or footage from lines SE-SE-SW
Lease Owner Sohio Petroleum Company.
Lease Name Rhoades Well No. #1
Office Address Russell, Kansas.
Character of Well (completed as Oil, Gas or Dry Hole) Dry Hole
Date well completed 8-12 19 51
Application for plugging filed 8-12 19 51
Application for plugging approved 8-12 19 51
Plugging commenced 8-12 19 51
Plugging completed 8-12 19 51
Reason for abandonment of well or producing formation Dry Hole

If a producing well is abandoned, date of last production 19.....
Was permission obtained from the Conservation Division or its agents before plugging was commenced? Yes Verbal

Name of Conservation Agent who supervised plugging of this well Eldon Petty
Producing formation..... Depth to top..... Bottom..... Total Depth of Well 4200 Feet
Show depth and thickness of all water, oil and gas formations.

OIL, GAS OR WATER RECORDS

CASING RECORD

Formation	Content	From	To	Size	Put In	Pulled Out
<u>Soil & shale</u>		<u>0</u>	<u>222'</u>	<u>8 5/8"</u>	<u>222'</u>	<u>none</u>
<u>Kansas City</u>		<u>3693'</u>	<u>3892'</u>		<u>dry</u>	<u>dry</u>
<u>Arbuckle</u>		<u>4162'</u>	<u>4200'</u>		<u>dry</u>	<u>dry</u>

Describe in detail the manner in which the well was plugged, indicating where the mud fluid was placed and the method or methods used in introducing it into the hole. If cement or other plugs were used, state the character of same and depth placed, from..... feet to..... feet for each plug set.

Stirred pits well, filled hole with heavy mud. Placed wood plug and 1/2 sack hulls at 220'. Ran 10 sacks cement. Filled hole with mud to 40'. Placed wood plug at 40'. Ran 1/2 sack hulls and 15 sacks cement, filling hole to bottom cellar.

RECEIVED
STATE OF KANSAS
8-17-1951
AUG 17 1951
WICHITA, KANSAS

(If additional description is necessary, use BACK of this sheet)

Correspondence regarding this well should be addressed to Sohio Petroleum Company
Address Russell, Kansas.

STATE OF Kansas, COUNTY OF Ellis, ss.
T.C. Strain (employee of owner) or (owner or operator) of the above-described well,
being first duly sworn on oath, says: That I have knowledge of the facts, statements, and matters herein contained and the log of the above-described well as filed and that the same are true and correct. So help me God.
(Signature) T.C. Strain

Box 188, Hays, Kansas.
(Address)

SUBSCRIBED AND SWORN to before me this 16 day of August, 19 51

My commission expires July 18, 1955
Dolores Ann Fair Notary Public.

PLUGGING
FILE SEC 35 T 11 R 23W
BOOK PAGE 102 LINE 41

COMPANY: SOHIO PETROLEUM COMPANY

SE-SE-SW, Sec. 35,
Twp. 11S, Rge. 23W,
Trego County, Kansas.

LEASE: Rhoades #1,

ELEVATION: 2436 R.B.

NOTE: All meas. rotary bushings.

0	5 Cellar
5	45 Shale & soil
45	120 Sand
120	210 Shale & shells
210	222 Shale & shells
222	940 Shale & shells
940	1030 Sand
1030	1110 Shale, shells, Pyrite
1110	1420 Shale, & sand
1410	1635 Sand
1635	1730 Shale & shells
1730	1750 Lime
1750	1776 Shale
1776	1874 Shale & redbed
1874	1985 Lime
1985	2075 Shale & Redbed
2075	2150 Shale & Redbed
2150	2375 Shale & shells
2375	2535 Shale & shells
2535	2700 Shale & shells
2700	2820 Shale & shells
2820	2900 Lime & shale
2900	3090 Lime & shale
3090	3190 Lime & shale
3190	3265 Lime & shale
3265	3295 Lime, Hard
3295	3365 Lime & shale
3365	3433 Shale & lime
3433	3510 Lime & shale
3510	3575 Shale & lime
3575	3625 Shale & lime
3625	3675 Lime & shale
3675	3690 Lime
3690	3733 Lime
3733	3776 Lime
3776	3810 Lime
3810	3848 Lime
3848	3889 Lime
3889	3916 Lime
3916	3974 Lime
3974	4022 Lime
4022	4062 Lime
4062	4109 Lime & shale
4109	4145 Lime & shale
4145	4169 Chert & lime,
4169	4192 Lime
4192	4200 Lime
4200	T.D. (rotary bushing meas.)

TOPS:

Heebner	3653
Lans. K.C.	3693
B.K.C.	3692
Harnston	4035
Cherty Cong.	4115
Arbuckle	4132
T.D.	4200

CASING RECORD:

8 5/8" Surface Casing set at 222' with 150 lbs cement, (bulk) by Halliburton.

D.S.T. By Johnston Testing Co.

4042'-4062'. Tool on in 1 Hour. Recovered 242' very slightly Oil cut muddy Slat water. B.H.P. 18 min. 680# Pres. Medium to weak blow thru-out test.

Run Schlumberger Logs (3) to total Depth.

COMMENCED: 7-30-51
COMPLETED: 8-12-51

8-17-1951

STATE OF KANSAS) SS.
COUNTY OF ELLIS)

I hereby affirm that the above and foregoing is a true, and correct copy of the log of the Rhoades #1, located SE-SE-SW, Sec. 35, Twp. 11S, Rge. 23W, Trego County, Kansas.

CONTRACTOR: Strain Drilling Co.

BY T.C. Strain
T.C. Strain

Subscribed and sworn to before me this 16 day of August, 1951

My Commission expires July 18, 1955.
Roberta Ann Frain

PLUGGING
FILE SEC 35 T 11 R 23W
BOOK PAGE 127 LINE 41