


15-195-20363-00-00

FORM CP-4

STATE OF KANSAS
STATE CORPORATION COMMISSION
CONSERVATION DIVISION
P. O. BOX 17027
WICHITA, KANSAS 67217

WELL PLUGGING RECORD

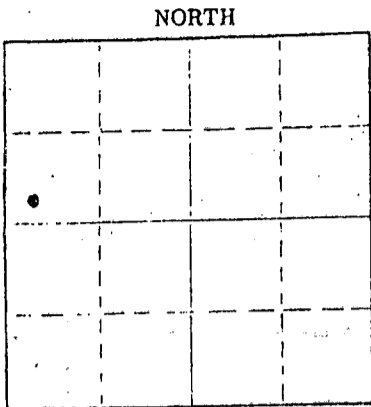

Locate well correctly on above Section Plat

Trego County, Sec. 36 Twp. 11 Rge. 23 (E) W (W)
Location as "NE/CNWSW" or footage from lines SW SW NW
Lease Owner Bankoff Oil Company
Lease Name Butcher Well No. 1
Office Address P.O. Drawer 2479/Tulsa, OK 74101
Character of Well (completed as Oil, Gas or Dry Hole) Dry Hole
Date well completed 3-23 19 76
Application for plugging filed 3-23 19 76
Application for plugging approved 3-23 19 76
Plugging commenced 3-23 19 76
Plugging completed 3-23 19 76
Reason for abandonment of well or producing formation

If a producing well is abandoned, date of last production 19
Was permission obtained from the Conservation Division or its agents before plugging was commenced? YES

Name of Conservation Agent who supervised plugging of this well Gilbert Balthazor (Palco, KS)
Producing formation Depth to top Bottom Total Depth of Well 3771' Feet
Show depth and thickness of all water, oil and gas formations. K.B.

Oil, Gas or Water Records and Casing Record table with columns: FORMATION, CONTENT, FROM, TO, SIZE, PUT IN, PULLED OUT. Entry: 8 5/8, 213', NONE.

Describe in detail the manner in which the well was plugged, indicating where the mud fluid was placed and the method or methods used in introducing it into the hole. If cement or other plugs were used, state the character of same and depth placed, from feet to feet for each plug set.

Plugged w/70 sacks 50/50 Pozmix, 6% Gel @ 700 ft.
20 sacks 50/50 Pozmix, 6% Gel @ 200 ft.
10 sacks 50/50 Pozmix, 6% Gel, bridge & plug @ 40 ft.
Job completed @ 9:00 P.M.

Name of Plugging Contractor Allen Drilling Company
Address P.O. Box 1389/Great Bend, KS 67530

STATE OF Kansas COUNTY OF Barton ss.
Allen Drilling Company (employee of owner) or (owner or operator) of the above-described


well, being first duly sworn on oath, says: That I have knowledge of the facts, statements, and matters herein contained and the log of the above-described well as filed and that the same are true and correct. So help me God.

(Signature) Lenny J. Bishop
P.O. Box 1389/Great Bend, KS 67530 (Address)

Subscribed and sworn to before me this 24th day of March, 1976

My commission expires 11-25-79

Lavelta M. Murnahan Notary Public.

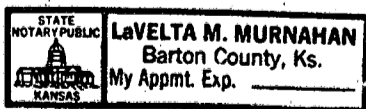

RECEIVED
CONSERVATION COMMISSION
4-21-1976
APR 21 1976

CONSERVATION DIVISION
Wichita, Kansas

15-195-20363-00-00

DRILLER'S WELL LOG

DATE COMMENCED: 3-18-76
DATE COMPLETED: 3-23-76

Bankoff Oil Company
Butcher #1
SW SW NW, Sec. 36-11S-23W
Trego County, Kansas

ELEVATIONS 2403 K.B.
2397 G.L.

0- 330' Shale
330-1832' Shale & Sand
1832-1877' Anhydrite
1877-1885' Shale
1885-3400' Lime & Shale
3400-3622' Lime
3622-3625' Shale
3625-3771' Lime
3771' RTD

FORMATION DATA

Anhydrite 1832
Heebner 3622
Toronto 3644
Lansing-KC 3660
RTD 3771

SURFACE PIPE:
Set 213' of 8 5/8", 28#
used pipe w/150 sacks Common,
3% cc. 2% Gel.

PLUGGING:
Plugged w/70 sacks 50/50 Pozmix,
6% Gel @ 700 ft.
20 sacks 50/50 Pozmix,
6% Gel @ 200 ft.
10 sacks 50/50 Pozmix,
6% Gel, bridge & plug @ 40 ft.
Job completed @ 9:00 P.M.

RECEIVED
STATE CORPORATION COMMISSION
4-21-1976
APR 21 1976

CONSERVATION DIVISION
Wichita, Kansas

AFFIDAVIT

STATE OF KANSAS)
COUNTY OF BARTON) ss.

Glenn J. Bishop, of lawful age, does swear and state that the facts and statements herein contained are true and correct to the best of his knowledge.

Glenn J. Bishop

Subscribed and sworn to before me this 19th day of April 1976.

ALLEN DRILLING CO.
P. O. BOX 1389
GREAT BEND, KANSAS 67530

Lavelta M. Murnahan
(Notary Public)

My commission Expires: 11-25-79

