

WELL PLUGGING RECORD


STATE OF KANSAS STATE CORPORATION COMMISSION

FORMATION PLUGGING RECORD

Give All Information Completely Make Required Affidavit Mail or Deliver Report to: Conservation Division State Corporation Commission 800 Bitting Building Wichita, Kansas

Strike out upper line when reporting plugging off formations.

NORTH

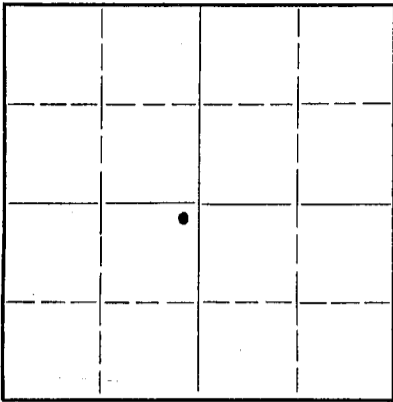

Locate well correctly on above Section Plat

Ellis County, Sec. 8 Twp. 11 Rge. 19 (E) W (W) Location as "NE 1/4 NW 1/4 SW 1/4" or footage from lines NE corner of the SW 1/4 Lease Owner N. Appleman Co. Lease Name Gunther Office Address Box 88, Wichita, Kansas Well No. 2 Character of Well (completed as Oil, Gas or Dry Hole) Dry Hole Date well completed January 2, 1943 Application for plugging filed January 2, 1943 Application for plugging approved by telephone, January 2, 1943 Plugging commenced January 2, 1943 Plugging completed January 2, 1943 Reason for abandonment of well or producing formation Dry Hole

If a producing well is abandoned, date of last production 19. Was permission obtained from the Conservation Division or its agents before plugging was commenced? Yes

Name of Conservation Agent who supervised plugging of this well C. T. Alexander Producing formation Depth to top Bottom Total Depth of Well 369.9 Feet Show depth and thickness of all water, oil and gas formations.


OIL, GAS OR WATER RECORDS

CASING RECORD

Table with 7 columns: Formation, Content, From, To, Size, Put In, Pulled Out. The table is currently empty.

Describe in detail the manner in which the well was plugged, indicating where the mud fluid was placed and the method or methods used in introducing it into the hold. If cement or other plugs were used, state the character of same and depth placed, from feet to feet for each plug set.

Filled with heavy mud from bottom of the hole to 240 feet, bridged at 240 ft. and filled with cement to 195 feet. (15 sacks). Filled with mud to 26 ft. and cemented to 6 feet, surfaced pipe, cut and plugged.

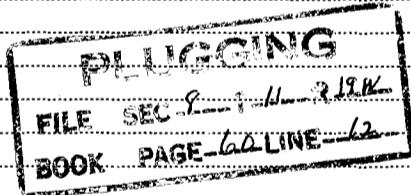

(If additional description is necessary, use BACK of this sheet)

Correspondence regarding this well should be addressed to Roberts Drilling Company Address P.O. Box 487, Russell, Kansas

STATE OF Kansas, COUNTY OF Russell, ss. C.L. Roberts (employee of owner) or (owner or operator) of the above-described well, being first duly sworn on oath, says: That I have knowledge of the facts, statements, and matters herein contained and the log of the above-described well as filed and that the same are true and correct. So help me God.

(Signature) [Signature] 1-6-1943 P.O. Box 487, Russell, Kansas (Address)

SUBSCRIBED AND SWORN to before me this 5th day of January, 1943 [Signature] Notary Public.

My commission expires July 2, 1945.

H. Applemann Co.
Gunter #1

Sec. 8 T. 11 R. 19
NE c of SW 4
330' NE 330' EL

Total depth 3699'
Cora. 12-13-42 Comp. 1/3/43

County, Ellis

Casing:
Surface Casing, Set 246'

Cement:
75 sacks

Figures Indicate Bottom of Formation

blue and brown shale shelly	246
shale and shells	510
shale shells red rock	930
shale and red rock	1230
shale and shells	1380
red bed	1417
anhydrite	1467
shale	1530
shale and sand	1605
shale shells red rock	1760
shale shells salt	1880
shale and shells	2020
shale lime sand	2134
shale and lime	2410
lime	2495
shale and lime	2720
shale	2755
shale and lime	2820
shale	3080
lime	3090
shale	3125
shale and lime	3180
lime	3570
lime cherty	3641
chert shale lime	3699 top Sil. lens - 2677
Total Depth	

PLUGGING

State of Kansas)
Russell County) SS

1-6-1943
JAN 6

I hereby certify that the above information is true and correct to the best of my knowledge.

Ch. Roberts

Subscribed and sworn to before me this 5th day of January, 1943

My commission expires July 2, 1945

Venevise Pash
Notary Publ