

Give All Information Completely
Make Required Affidavit
Mail or Deliver Report to:
Conservation Division
State Corporation Commission
212 No. Market
Wichita, Kansas

WELL PLUGGING RECORD

Trego County. Sec. 2 Twp. 11S Rge. 1(E)24 (W)

Location as "NE/CNW/SW" or footage from lines C SE NE

Lease Owner McClure Oil Co. & Abercrombie Drilling, Inc.

Lease Name MARY WEBER Well No. 1

Office Address 801 Union Center

Character of Well (completed as Oil, Gas or Dry Hole) Dry Hole

Date well completed August 15, 19 67

Application for plugging filed (verbally) August 15, 19 67

Application for plugging approved " August 15, 19 67


Plugging commenced August 15, 19 67

Plugging completed August 15, 19 67

Reason for abandonment of well or producing formation Dry Hole

If a producing well is abandoned, date of last production _____ 19 _____

Was permission obtained from the Conservation Division or its agents before plugging was commenced? Yes

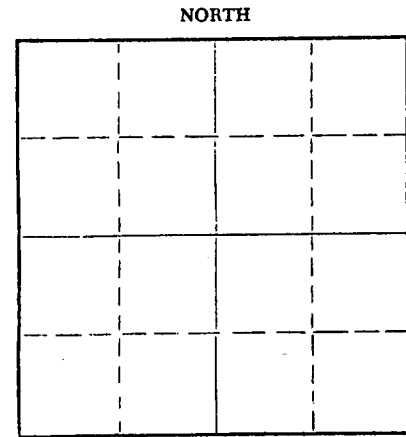

Locate well correctly on above Section Plat

Name of Conservation Agent who supervised plugging of this well Bill Nichols

Producing formation _____ Depth to top _____ Bottom _____ Total Depth of Well 3940 Feet

Show depth and thickness of all water, oil and gas formations.

OIL, GAS OR WATER RECORDS

CASING RECORD

FORMATION	CONTENT	FROM	TO	SIZE	PUT IN	PULLED OUT
				7"	202'	None

Describe in detail the manner in which the well was plugged, indicating where the mud fluid was placed and the method or methods used in introducing it into the hole. If cement or other plugs were used, state the character of same and depth placed, from _____ feet to _____ feet for each plug set.

First plug was set @ 1320' with 60 sx. cement. Second plug @ 210' with 15 sacks, and the top plug was set at 40' with 5 sacks. Well was plugged with pump truck thru drillpipe.

RECEIVED
8-21-1967
AUG 21 1967

(If additional description is necessary, use BACK of this sheet)

Name of Plugging Contractor Abercrombie Drilling, Inc.

Address West Tenth Street, Great Bend, Kansas

STATE OF KANSAS, COUNTY OF SEDGWICK, ss.

A. L. Abercrombie (employee of owner) of the above-described well, being first duly sworn on oath, says: That I have knowledge of the facts, statements, and matters herein contained and the log of the above-described well as filed and that the same are true and correct. So help me God.

(Signature) [Signature]

801 Union Center, Wichita, Kansas
(Address)

SUBSCRIBED AND SWORN to before me this 16th day of August, 19 67

My commission expires March 31, 1970

Margo Dee Montgomery
Margo Dee Montgomery Notary Public.

