


WELL PLUGGING RECORD

Give All Information Completely  
 Make Required Affidavit

COUNTY Trego SEC. 2 TWP. 11S RGE. 24W ~~EXW~~  
 Location as in quarters or footage from lines:  
SE SE NW

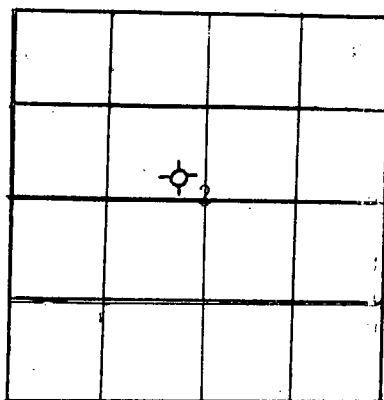

Locate Well  
 correctly on above  
 Section Platt.

Lease Owner Gear Petroleum Company, Inc.  
 Lease Name GARRETT Well No. #1-2  
 Office Address 300 Sutton Place, Wichita, KS 67202  
 Character of Well (Completed as Oil, Gas or Dry Hole): Dry Hole(c)(L)  
 Date Well Completed April 29, 1983  
 Application for plugging filed Yes  
 Plugging commenced \_\_\_\_\_  
 Plugging completed 11:30 A.M., 4-29-83  
 Reason for abandonment of well or producing formation \_\_\_\_\_

Was permission obtained from the Conservation Division or it's  
 Agent's before plugging was commenced? Yes

Name of Conservation Agent who supervised plugging of this well David Wann

Producing formation \_\_\_\_\_ Depth to top \_\_\_\_\_ bottom T.D. 4200'

Show depth and thickness of all water, oil and gas formations.

OIL, GAS OR WATER RECORDS Casing Record

Formation	Content	From	To	Size	Put in	Pulled Out
				8-5/8"	229'	

Describe in detail the manner in which the well was plugged, indicating where the mud  
 fluid was placed and the method or methods used in introducing it into the hold. If cement  
 or other plugs were used, state the character of same and depth placed, from \_\_\_\_\_ feet  
 to \_\_\_\_\_ feet for each plug set.


- Plug #1 @ 1950' w/20 sks. cement
- Plug #2 @ 1045' w/100 sks. cement
- Plug #3 @ 375' w/ 40 sks. cement
- Plug #4 @ 40' w/10 sks. cement
- 10 sks. cement in rathole

(If additional description is necessary, use BACK of this sheet)

Name of Plugging Contractor John O. Farmer, Inc.  
P.O. Box 352, Russell, KS 67665

STATE OF Kansas COUNTY OF Sedowick, ss.

Jim Thatcher, Drilg & Prod Manager (employee of owner) or (owner or operator) of the  
 above-described well, being first duly sworn on oath, says: That I have knowledge of the  
 facts, statements, and matters herein contained and the log of the above-described well as  
 filed and that the same are true and correct. So help me God.

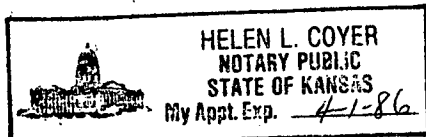

(Signature) Jim Thatcher  
300 SUTTON PLACE WICHITA KS  
 (Address) 67202

SUBSCRIBED AND SWORN TO before me this 5th day of May, 19 83


Helen L. Coyer  
 Notary Public.  
 STATE CORPORATION COMMISSION

RECEIVED  
 STATE CORPORATION COMMISSION

5-6-1983  
 MAY 06 1983