

STATE OF KANSAS
STATE CORPORATION COMMISSION


15-195-20774-00-00

WELL PLUGGING RECORD

Give All Information Completely
Make Required Affidavit
Mail or Deliver Report to:
Conservation Division
State Corporation Commission
212 North Market, Insurance Bldg.
Wichita, Kansas

Trego County, Sec. 4 Twp. 11S Rge. 24W (W)

Location as "NE/CNW/SW" or footage from lines SW NW NW
Lease Owner John O. Farmer, Inc.
Lease Name Ott "B" Well No. #1
Office Address P.O. Box 352, Russell, KS 67665
Character of Well (completed as Oil, Gas or Dry Hole) Dry Hole
Date well completed March 20, 19 81
Application for plugging filed Yes 19
Application for plugging approved 19
Plugging commenced 19
Plugging completed 6:45 p.m., March 20, 19 81
Reason for abandonment of well or producing formation _____

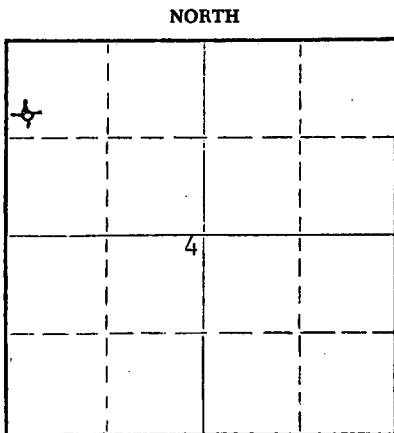

Locate well correctly on above Section Plat

If a producing well is abandoned, date of last production 19
Was permission obtained from the Conservation Division or its agents before plugging was commenced? Yes

Name of Conservation Agent who supervised plugging of this well Gilbert Balthazor
Producing formation _____ Depth to top _____ Bottom _____ Total Depth of Well _____ Feet

Show depth and thickness of all water, oil and gas formations.

OIL, GAS OR WATER RECORDS

CASING RECORD

FORMATION	CONTENT	FROM	TO	SIZE	PUT IN	PULLED OUT

Describe in detail the manner in which the well was plugged, indicating where the mud fluid was placed and the method or methods used in introducing it into the hole. If cement or other plugs were used, state the character of same and depth placed, from _____ feet to _____ feet for each plug set.

Plug #1 @ 840' w/70 sxs. cement
Plug #2 @ 200' w/20 sxs. cement
Plug #3 @ 40' w/10 sxs. cement

(If additional description is necessary, use BACK of this sheet)

Name of Plugging Contractor John O. Farmer, Inc.
Address P.O. Box 352, Russell, KS 67665

STATE OF Kansas COUNTY OF Russell, ss.
John O. Farmer III (owner or operator) of the above-described

well, being first duly sworn on oath, says: That I have knowledge of the facts, statements, and matters herein contained and the log of the above-described well as filed and that the same are true and correct. So help me God.

(Signature) John O. Farmer III
P.O. Box 352, Russell, KS 67665
(Address)

SUBSCRIBED AND SWORN TO before me this 24th day of March, 19 81

My commission expires Jan. 27, 1985

Margaret A. Schulte
Margaret A. Schulte, Notary Public.
STATE CORPORATION COMMISSION

3-26-1981
MAR 26 1981

15-195-20774-00-00


KANSAS DRILLERS LOG

S. 4 T. 11S R. 24W ^{XX} _W

Loc. SW NW NW

County Trego

640 Acres
N

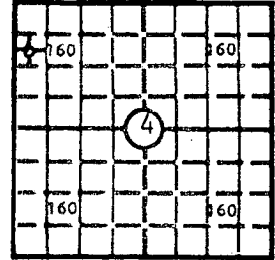

Locate well correctly
2328'

Elev.: Gr.

DF 2331' KB 2333'

API No. 15 — 195 — 20,774-00-00
County Number

Operator
John O. Farmer, Inc.

Address
P.O. Box 352, Russell, KS 67665

Well No. #1 Lease Name Ott "B"

Footage Location
990 feet from (N) ^{XX} line 330 feet from ^{XX} (W) line

Principal Contractor John O. Farmer, Inc. Geologist Sam L. Farmer

Spud Date 3-14-81 Total Depth 3935' P.B.T.D.

Date Completed 3-20-81 Oil Purchaser

CASING RECORD

Report of all strings set — surface, intermediate, production, etc.

Purpose of string	Size hole drilled	Size casing set (in O.D.)	Weight lbs/ft.	Setting depth	Type cement	Sacks	Type and percent additives
Surface	12-1/4"	8-5/8"	24	208'	Common	175	

LINER RECORD

PERFORATION RECORD

Top, ft.	Bottom, ft.	Sacks cement	Shots per ft.	Size & type	Depth interval

Size	Setting depth	Packer set at

ACID, FRACTURE, SHOT, CEMENT SQUEEZE RECORD

Amount and kind of material used	Depth interval treated

RECEIVED
STATE CORPORATION COMMISSION
3-26-1981
MAR 26 1981

INITIAL PRODUCTION

CONSERVATION DIVISION
Wichita, Kansas

Date of first production Producing method (flowing, pumping, gas lift, etc.)

RATE OF PRODUCTION PER 24 HOURS
Oil Gas Water Gas-oil ratio
bbis. MCF bbis. CFPB

Disposition of gas (vented, used on lease or sold) Producing interval (s)

INSTRUCTIONS: As provided in KCC Rule 82-2-125, within 90 days after completion of a well, one completed copy of this Drillers Log shall be transmitted to the State Geological Survey of Kansas, 4150 Monroe Street, Wichita, Kansas 67209. Copies of this form are available from the Conservation Division, State Corporation Commission, 3830 So. Meridian (P.O. Box 17027), Wichita, Kansas 66217. Phone AC 316-522-2206. If confidential custody is desired, please note Rule 82-2-125. Drillers Logs will be on an open file in the Oil and Gas Division, State Geological Survey of Kansas, Lawrence, Kansas 66044.

Operator: John O. Farmer, Inc. DESIGNATE TYPE OF COMP.: OIL, GAS, DRY HOLE, SWDW, ETC.:

Well No. #1 Lease Name: Ott "B" Dry Hole

S 4 T 11S R 24W W

WELL LOG

Show all important zones of porosity and contents thereof; cored intervals, and all drill-stem tests, including depth interval tested, cushion used, time tool open, flowing and shut-in pressures, and recoveries.

SHOW GEOLOGICAL MARKERS, LOGS RUN, OR OTHER DESCRIPTIVE INFORMATION.

FORMATION DESCRIPTION, CONTENTS, ETC.	TOP	BOTTOM	NAME	DEPTH
Sand & Shale	0	370		<u>Sample Tops</u>
Shale & Sand	370	1495		
Sand	1495	1718		
Red Bed	1718	1954	Anhydrite	1954 (+379)
Anhydrite	1954	2000	Heebner	3651 (-1318)
Shale & Shells	2000	2245	Toronto	3676 (-1343)
Shale & Lime	2245	2510	Lansing	3690 (-1357)
Lime & Shale	2510	2700	B/KC	3930 (-1597)
Shale & Lime	2700	3080	T.D.	3935 (-1602)
Lime & Shale	3080	3220		
Shale & Lime	3220	3500		
Lime & Shale	3500	3735		
Lime	3735	3935		

DST #1 3810-43
 Tool open 30-45-5, weak blow - 25 min.
 Rec: 10' mud
 BHP: 1245
 FP: 55-55

USE ADDITIONAL SHEETS, IF NECESSARY, TO COMPLETE WELL RECORD.

Date Received

John O. Farmer III
 Signature
 Vice-President
 Title
 March 24, 1980
 Date