


Give All Information Completely
Make Required Affidavit
Mail or Deliver Report to:
Conservation Division
State Corporation Commission
212 No. Market
Wichita, Kansas

WELL PLUGGING RECORD

Trego County, Sec. 10 Twp. 11S Rge. 24 (W)

Location as "NE/CNW/SW" or footage from lines NE NW
Lease Owner McClure Oil Co. and Abercrombie Drilling, Inc.
Lease Name HOLLANDWORTH Well No. 1
Office Address 801 Union Center; Wichita, Kansas
Character of Well (completed as Oil, Gas or Dry Hole) Dry Hole
Date well completed August 7, 19 67
Application for plugging filed (verbally) August 7, 19 67
Application for plugging approved (verbally) August 7, 19 67
Plugging commenced August 7, 19 67
Plugging completed August 7, 19 67
Reason for abandonment of well or producing formation Dry Hole

If a producing well is abandoned, date of last production 19
Was permission obtained from the Conservation Division or its agents before plugging was commenced? Yes

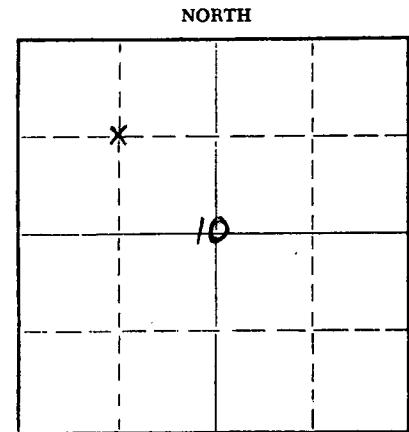

Locate well correctly on above Section Plat

Name of Conservation Agent who supervised plugging of this well Bill Nichols
Producing formation _____ Depth to top _____ Bottom _____ Total Depth of Well 3915 Feet
Show depth and thickness of all water, oil and gas formations.

OIL, GAS OR WATER RECORDS

CASING RECORD

FORMATION	CONTENT	FROM	TO	SIZE	PUT IN	PULLED OUT
				7"	204'	None

Describe in detail the manner in which the well was plugged, indicating where the mud fluid was placed and the method or methods used in introducing it into the hole. If cement or other plugs were used, state the character of same and depth placed, from _____ feet to _____ feet for each plug set.

First plug was set at 1700' and cemented back to 1417' with 60 sacks of cement.
Second plug was set at 210' and cemented back to 140' with 15 sacks of cement.
Top plug was set at 40' and cemented to surface with 8 sacks of cement. Job was completed at 11:30 a.m., 8-7-67.

RECEIVED
STATE CORPORATION COMMISSION
8-11-1967
AUG 11 1967
CONSERVATION DIVISION
Wichita, Kansas

(If additional description is necessary, use BACK of this sheet)

Name of Plugging Contractor Abercrombie Drilling, Inc.
Address West Tenth Street; Great Bend, Kansas


STATE OF KANSAS, COUNTY OF SEDGWICK, ss.
A. L. Abercrombie (employee of owner) or (owner or operator) of the above-described well, being first duly sworn on oath, says: That I have knowledge of the facts, statements, and matters herein contained and the log of the above-described well as filed and that the same are true and correct. So help me God.

(Signature) A. L. Abercrombie
A. L. Abercrombie, President
801 Union Center; Wichita, Kansas
(Address)

SUBSCRIBED AND SWORN to before me this tenth day of August, 19 67

Margie Dee Montgomery
Margie Dee Montgomery, Notary Public.

My commission expires March 31, 1970

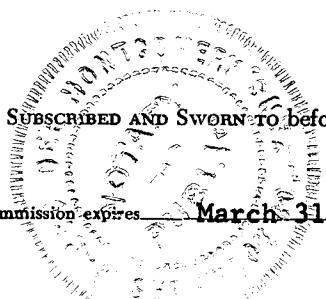

15-195-20029-00-00

CONTRACTOR'S WELL LOG

OWNER: McClure Oil Company
 CONTRACTOR: Abercrombie Drilling, Inc.
 FARM: HOLLANDWORTH #1
 LOCATION: NE NW, Sec. 10-11S-24W
 Trego County, Kansas
 COMMENCED: July 30, 1967
 COMPLETED: August 7, 1967

0	35	Sand
35	211	Shale
211	900	Shale w/pyrite streaks
900	1390	Shale and Red Bed
1390	1453	Shale and Sand
1453	1674	Sand
1674	1912	Red Bed
1912	1954	Anhydrite
1954	2390	Shale
2390	2605	Shale and Shells
2605	2747	Shale and Lime
2747	3400	Lime and Shale
3400	3610	Lime
3610	3696	Lime and Shale
3696	3915	Lime
	3915	Rotary Total Depth

RECEIVED
 STATE CORPORATION COMMISSION
 AUG 11 1967
 8-11-1967
 CONSERVATION DIVISION
 Wichita, Kansas

Set 7", 24# casing at 204' with 100 sacks of cement.
 Dry and Abandoned.

ELECTRIC LOG TOPS		ELEVATION
Heebner	3622 (-1319)	
Toronto	3645 (-1342)	2303 Kelly Bushing
Lansing	3659 (-1356)	2302 Derrick Floor
B/K.C.	3900 (-1597)	2296 Ground Level
T.D.	3915 (-1612)	

STATE OF KANSAS)
) SS
 COUNTY OF SEDGWICK)

I, A. L. Abercrombie, do hereby certify that the above is a correct and true copy of the HOLLANDWORTH #1, located in NE NW, Section 10-11S-24W, Trego County, Kansas, as reflected by the files of Abercrombie Drilling, Inc.

A. L. Abercrombie
 A. L. Abercrombie

Subscribed and sworn to before me, a Notary Public, in and for Sedgwick County, Kansas, as of the ninth day of August, 1967.

Margo Dee Montgomery
 Margo Dee Montgomery

My Commission Expires:

March 31, 1970